


SERENOA LAKES PHASE ~~1~~ & 2 (A.K.A. SERENOA VILLAGE 3 - PHASE ~~1~~, 2 & 3)

Prepared For:
VK AVALON GROVES, LLC
14025 RIVEREDGE DRIVE SUITE 175
TAMPA, FL 33637
Phone: (813) 615-1244

5904-A Hampton Oaks Parkway
Tampa, Florida 33610
Office: 813-253-5311
Fax: 813-464-7629

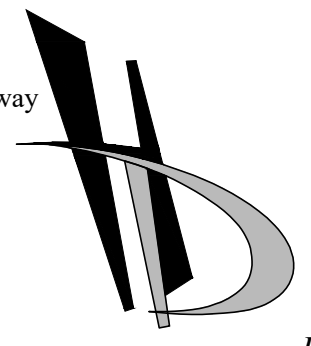

**HEIDT
DESIGN**
Civil Engineering • Planning & GIS
Transportation Engineering
Ecological Services • Landscape Architecture



Engineering Business Certificate of Authorization No. 28782
Landscape Architecture Certificate of Authorization No. LC26000405

~~RECORD~~ ~~CONSTRUCTION~~ PLAN SECTION 24, TOWNSHIP 24 SOUTH, RANGE 26 EAST LAKE COUNTY, FLORIDA


CALL 48 HOURS BEFORE YOU DIG



1-800-432-4770

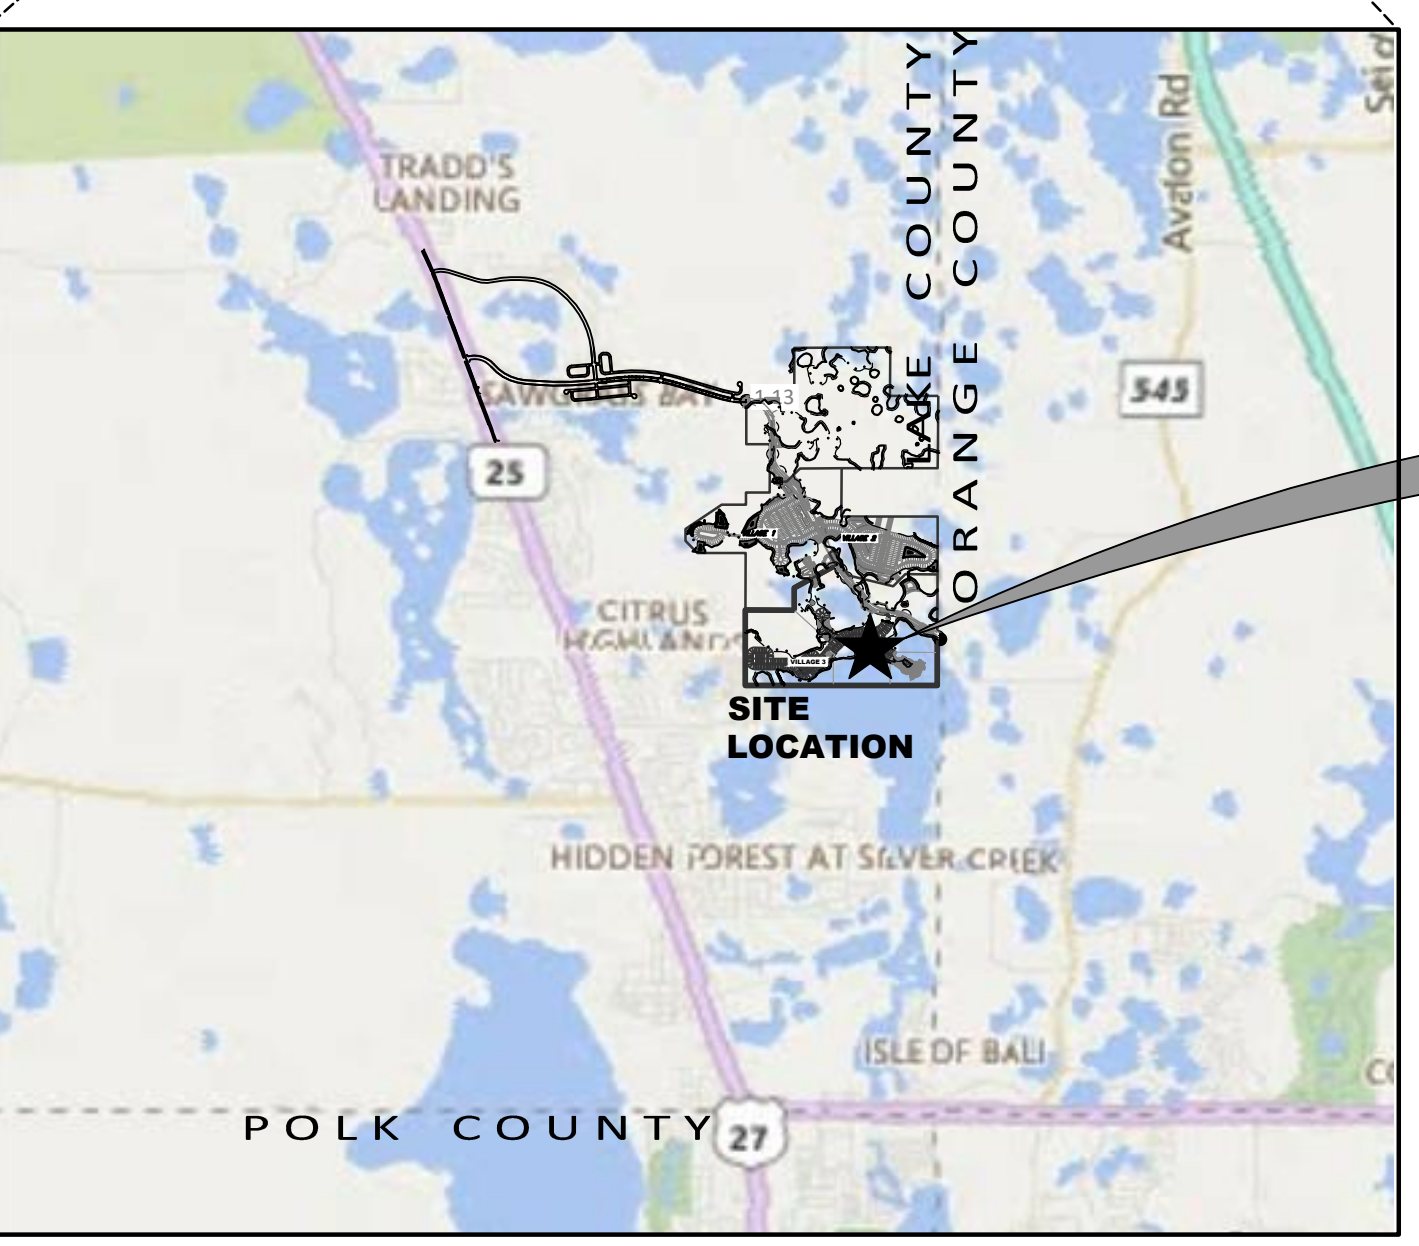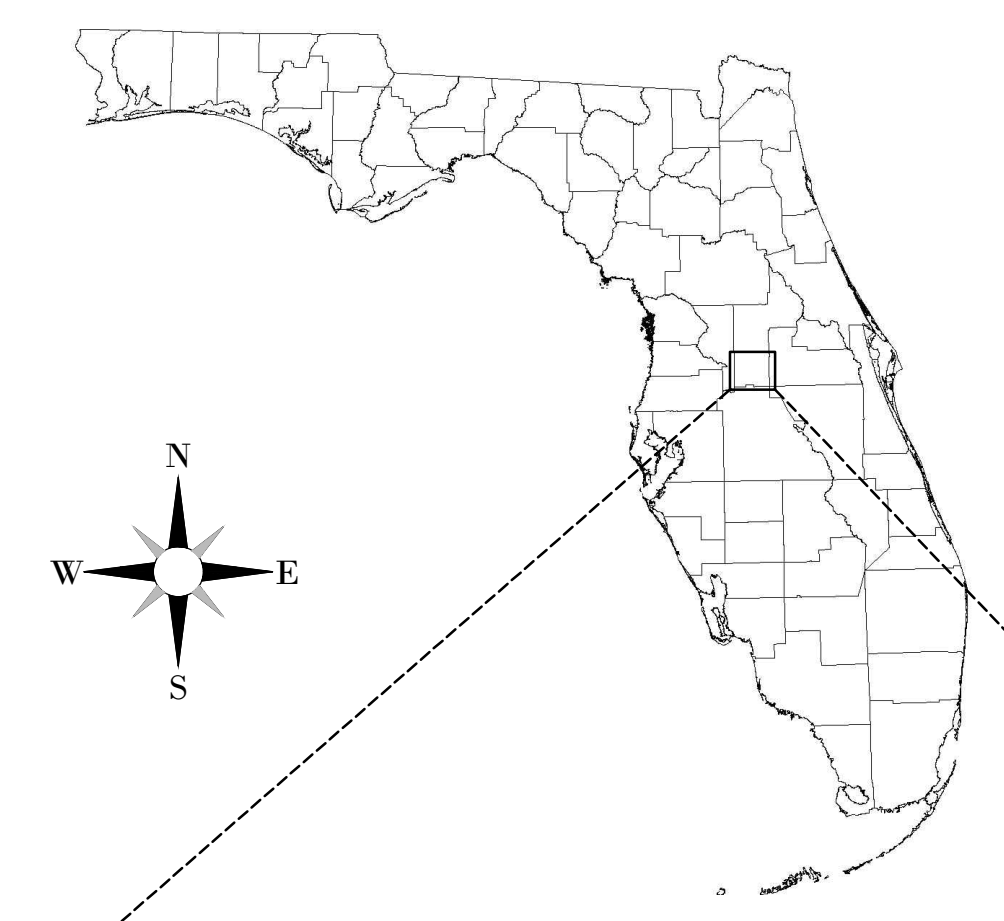

LOCATION MAP
(NOT TO SCALE)

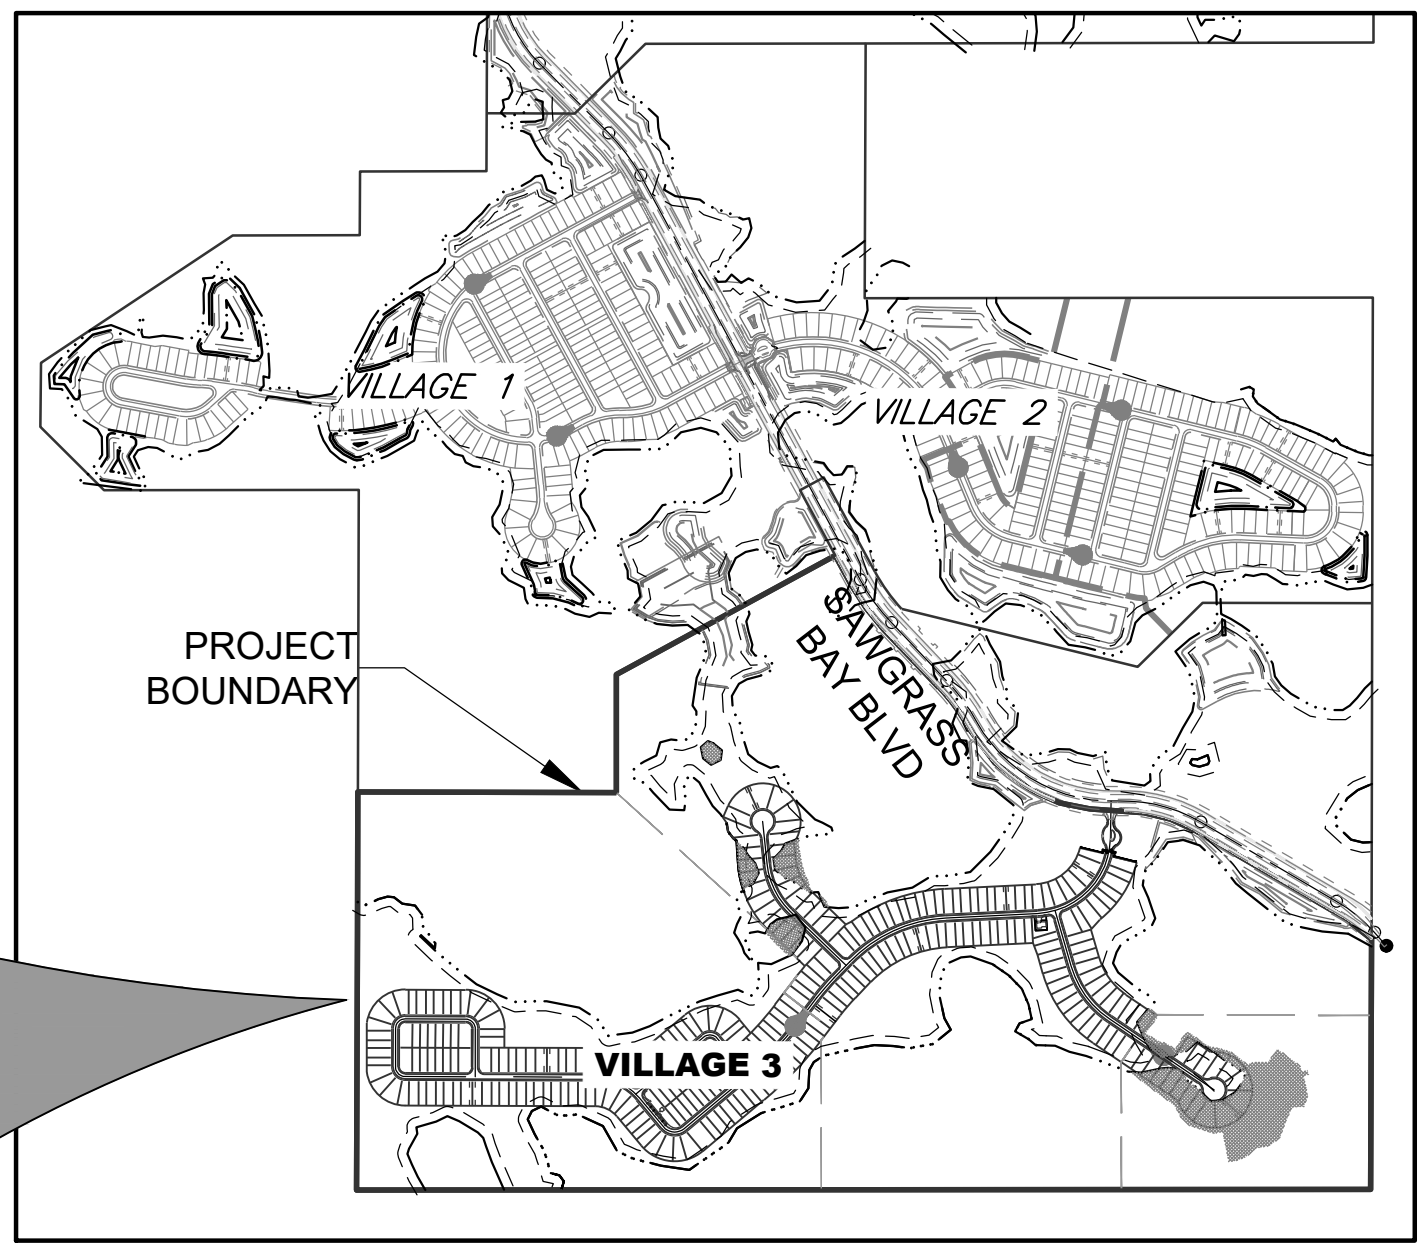

SITE MAP
(NOT TO SCALE)

RECORD DATA
PROVIDED BY
BLUE OXLAND
SERVICES

SERENOA
VILLAGE 3
PHASE 2
"RECORD DRAWINGS"

FACILITIES SHOWN HEREON HAVE BEEN, TO THE BEST OF MY KNOWLEDGE, CONSTRUCTED IN SUBSTANTIAL ACCORDANCE WITH APPROVED PLANS. SPECIFICATIONS AND MODIFICATIONS FOR THIS PROJECT, VERIFICATION IS BASED ON PERIODIC CONSTRUCTION OBSERVATION AND SURVEY NOTATIONS SHOWN ON PLANS. SURVEYED DIMENSIONS AND ELEVATIONS SHOWN AS RECORD INFORMATION HAVE BEEN FIELD VERIFIED.

LAST DATE OF FIELD SURVEY: 07/26/2021

RECORD DRAWING LEGEND	
42.00	PROPOSED/DESIGN ELEVATION OR DIMENSION LINED THROUGH, "RECORD" ELEVATION OR DIMENSION WRITTEN IN.
42.07	
X 5k.B	INDICATES RECORD ELEVATION
✓	INDICATES "RECORD" ELEVATION, DIMENSION, SLOPE, et cetera.
100	INDICATES "RECORD" ITEM NUMBER
8" W/M	INDICATES "RECORD" ITEM DESCRIPTION

NOTE: PER LDF CH. 6.06.01F, SOIL REMOVAL OFFSITE SHALL NOT EXCEED 200% OF THE MINIMUM STORMWATER RETENTION/DETENTION VOLUME REQUIRED.

NOTE: SEE SHEET C-104 FOR LEGAL DESCRIPTIONS.

Sheet List Table	
Sheet Number	Sheet Title
100 - GENERAL	
C-100	COVER SHEET
C-101 - C-103	GENERAL NOTES
C-104	AERIALSITE PLAN
C-105	EXISTING SITE CONDITIONS
C-105A	MASTER-SITE
C-106 - C-107	LOT GEOMETRY PLAN
200 - ROADWAY DETAILS	
C-200	TYPICAL ROADWAY SECTIONS
300 - DRAINAGE	
C-300	MASTER GRADING & DRAINAGE PLAN
C-301 - C-312	GRADING & DRAINAGE PLAN
C-313	STORM STRUCTURE DATA
C-314	CONTROL STRUCTURE DETAIL
C-315 - C-316	GRADING & DRAINAGE SECTIONS
C-317 - C-320	DRAINAGE DETAILS
400 - UTILITIES	
C-400	MASTER WATER & SEWER PLAN
C-401 - C-408	WATER & SEWER PLAN
500 - PLAN & PROFILE	
C-501 - C-512	ROADWAY PLAN & PROFILE
600 - UTILITY DETAILS	
C-600 - C-601	PUMP STATION DETAILS
C-602 - C-604	WATER & SEWER DETAILS
700 - PAVEMENT MARKING & SIDEWALKS	
C-700	SIGNING, PAVEMENT MARKING & SIDEWALK PLANS
C-701 - C-706	SIGNING, PAVEMENT MARKING & SIDEWALK PLANS
C-707 - C-708	SIGNING, PAVEMENT MARKING & SIDEWALK DETAILS AND NOTES
900 - ENGINEERING ADDENDA	
C-900	CONSTRUCTION SURFACE WATER MANAGEMENT PLAN
C-901	CONSTRUCTION SURFACE WATER MANAGEMENT PLAN NOTES
C-902	PRE-DEVELOPMENT DRAINAGE AREA MAP
C-903	OVERALL POST-DEVELOPMENT DRAINAGE AREA MAP
C-904 - C-905	DRAINAGE SUB-BASIN AREA MAP
C-906	FLOODPLAIN ENCROACHMENT & COMPENSATION
C-907 - C-909	UPLAND BUFFER AND C.E. SIGN LOCATIONS

THE FOLLOWING SUPPLEMENTAL PLAN SHEETS WERE NOT PREPARED UNDER THE RESPONSIBLE CHARGE OF THE ENGINEER OF RECORD:

LANDSCAPE PLANS PREPARED BY:
HEIDT DESIGN, LLC

SERENOA
VILLAGE 3 - PHASE 1, 2 & 3

VK AVALON GROVES, LLC

DATE	DESCRIPTION
8 01/05/2021	C-906
7 08/19/2020	C-600
6 07/30/2020	C-313, C-501-503, C-505-506, C-509-510
5 07/24/2020	C-508, C-600
4 07/02/2020	C-404, C-408
3 05/27/2020	C-106, C-200, C-300, C-302-304, C-307, C-308, C-400, C-401-408, C-501-509, C-511, C-603, C-700-703, C-705
2 03/20/2020	C-103, C-106, C-107, C-200, C-300, C-311, C-400, C-408, C-501, C-512, C-600, C-604, C-701, C-705, C-707
1 11/13/2019	C-300, C-302, C-303, C-308, C-310, C-313, C-401, C-404, C-407, C-501, C-502, C-504, C-509, C-511
11/08/2019	REVIEW SUBMITTAL
DATE	DESCRIPTION



DATE	DESCRIPTION
12/10/2021	ADDED PH 2 RECORD INFO CS01 THRU CS04 & CS12
12 11/15/2021	C-304, C-310, C-311
11 06/16/2021	C-105A, C-300, C-303
10 05/24/2021	C-313, C-501, C-502
9 3/08/2021	C-106, C-301, C-305, C-402, C-503
DATE	DESCRIPTION

© COPYRIGHT 2022, HEIDT DESIGN, LLC. ALL RIGHTS RESERVED. NO DOCUMENTATION (INCLUDING BUT NOT LIMITED TO DRAWINGS OR EXHIBITS) MAY BE COPIED, REPRODUCED, OR DISTRIBUTED UNLESS SPECIFIC WRITTEN PERMISSION HAS BEEN OBTAINED FROM HEIDT DESIGN, LLC. IN ADVANCE. CONSENT IS HEREBY GRANTED SPECIFICALLY TO GOVERNMENTAL AGENCIES TO REPRODUCE THIS DOCUMENTATION IN COMPLIANCE WITH F.S. CHAPTER 119.



ELEVATIONS BASED ON: NORTH AMERICAN VERTICAL DATUM 1988 CONVERSION: NAVD 88 TO NGVD 29 = +0.86	
ADDRESS CONTROL NUMBER	
WATER COMMITMENT	
SEWER COMMITMENT	
SWFVMD	
WATER DEP	
SEWER DEP	
FOLIO	
PERMIT / FILE NUMBERS	

STATE OF FLORIDA PROFESSIONAL ENGINEER	FILE:	COVER-REC
Timothy M. Plate, State of Florida, Professional Engineer, License No. 41153 <small>This date has been digitally signed and sealed by Timothy M. Plate, P.E., on the date indicated here.</small>	PROJECT NO:	KLP-AG-1089
	GRADING & DRAINAGE	
	DESIGN BY:	FRANCIS
	DRAWN BY:	JLOAIZA
	UTILITIES	
	DESIGN BY:	CBKALE
	DRAWN BY:	JLOAIZA
	COVER SHEET	
	C-100	
	TIMOTHY M. PLATE, P.E.	
	DATE:	
	LICENSE NO.	41153

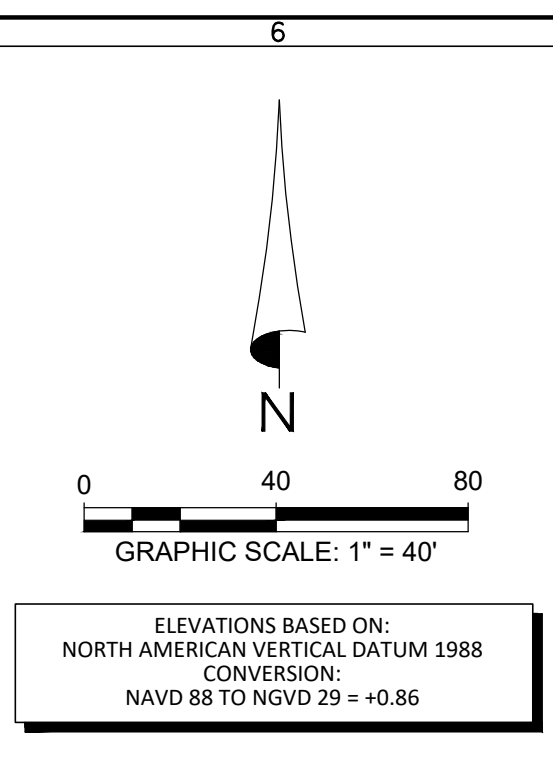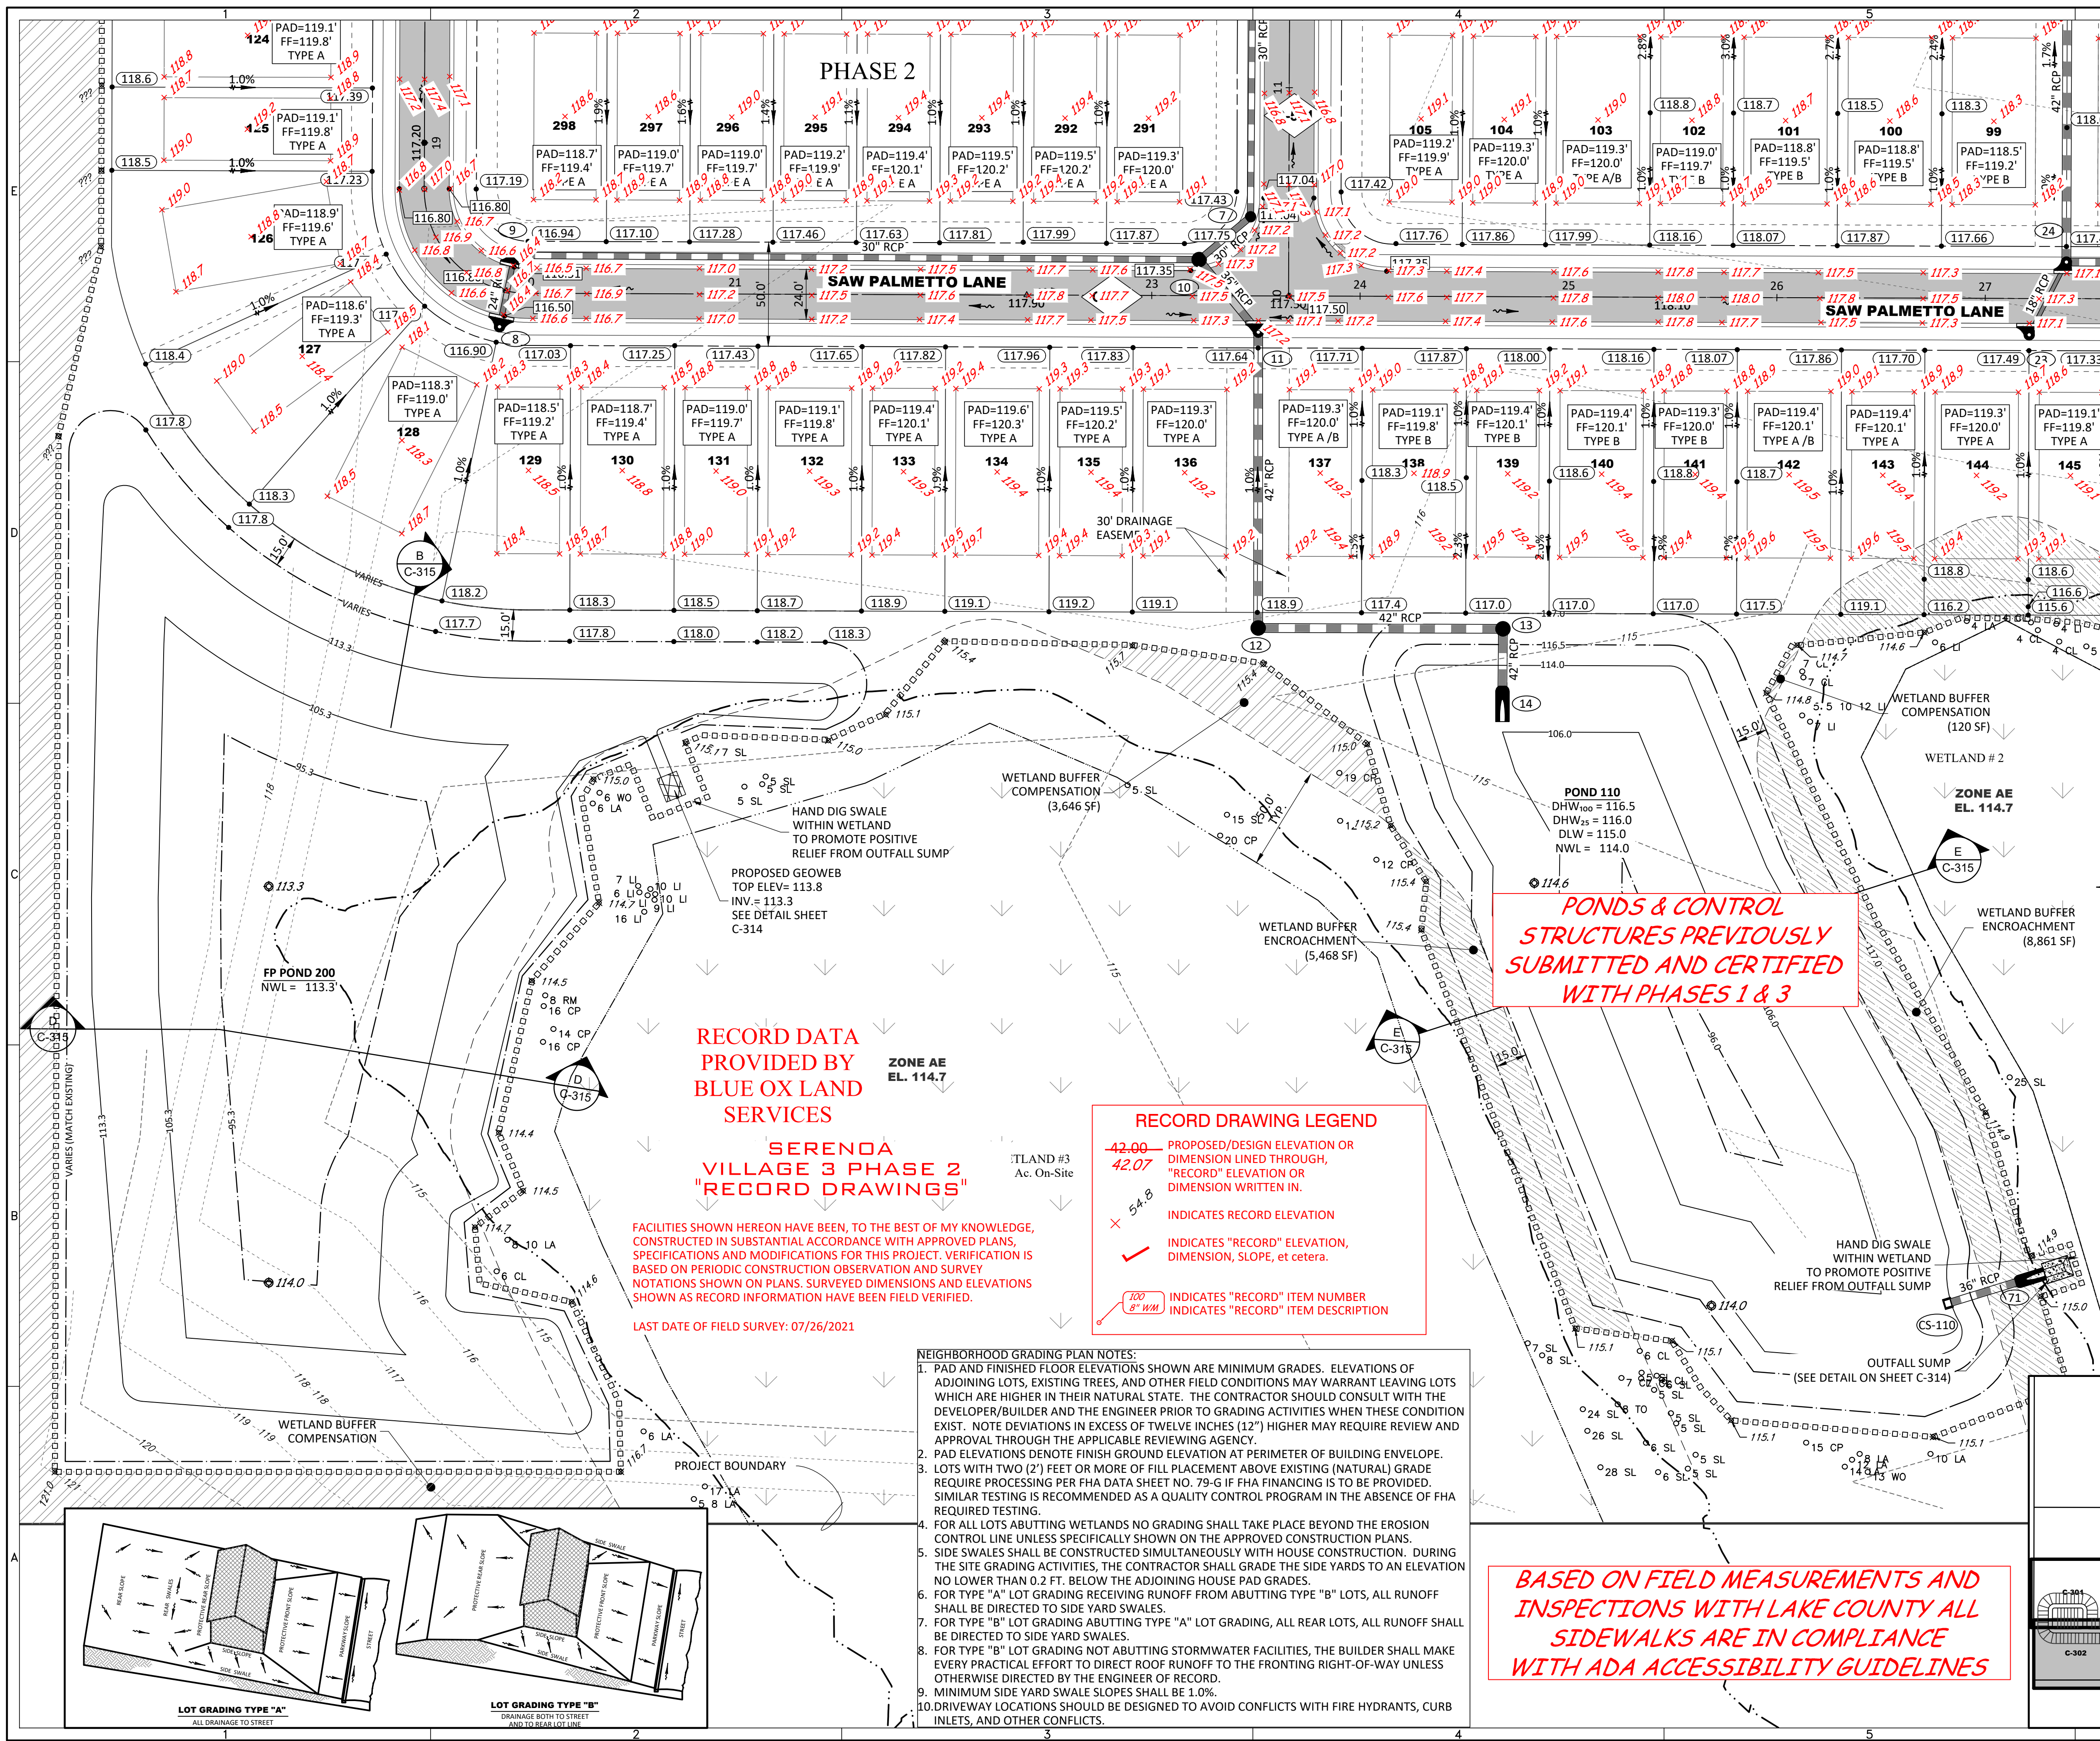

LEGEND

- SIRWMD WETLAND LINE
- SIRWMD WETLAND CONS. AREA SETBACK / LANDWARD EXTENT OF UPLAND BUFFER (50')
- FEMA LINE
- BOUNDARY LIMITS
- RIGHT-OF-WAY LINE
- PHASE LINE
- WETLAND IMPACT

DRAINAGE LEGEND

- EXISTING: 10 (STRUCTURE NO.), 15.00 (SPOT ELEVATION GROUND), 60.2 (TOP OF WALL), 55.9 (BOTTOM OF WALL), 15.00 (ROADWAY PROFILE ELEVATION), 15.00 (CONTOUR), 15.00 (FINISH FLOOR ELEVATION)
- PROPOSED: 10 (STORM DRAINAGE STRUCTURE & PIPE), CS-F (CONTROL STRUCTURE NO.), 15.00 (SPOT ELEVATION GROUND), 60.2 (TOP OF WALL), 55.9 (BOTTOM OF WALL), 15.00 (ROADWAY PROFILE ELEVATION), 15.00 (CONTOUR), 15.00 (FINISH FLOOR ELEVATION)
- FF=15.00 (FINISH FLOOR ELEVATION)
- Direction of surface flow (arrow)
- UNDERDRAIN WITH CLEANOUT
- STAKED EROSION CONTROL (SIRWMD PROJECT LIMITS AND THE LIMITS OF CLEARING AND FILLING)
- FLOATING TURBIDITY BARRIER
- BOTTOM OF POND/TOP OF BANK OF POND
- 6" WALL/FENCE (BY OTHERS)
- PLAN & PROFILE SHEET NUMBER (C-505)
- SECTION ID LABEL (A-A, C-317)
- SECTION SHEET NUMBER (P03)
- SOIL BORING (P03)
- WETLAND SETBACK ENCROACHMENT (hatched)
- WETLAND SETBACK COMPENSATION (dotted)

RECORD DRAWING LEGEND

- 42.00 (PROPOSED/DESIGN ELEVATION OR DIMENSION LINED THROUGH, "RECORD" ELEVATION OR DIMENSION WRITTEN IN)
- 54.8 (INDICATES RECORD ELEVATION)
- ✓ (INDICATES "RECORD" ELEVATION, DIMENSION, SLOPE, et cetera)
- 100 (INDICATES "RECORD" ITEM NUMBER)
- 8" (INDICATES "RECORD" ITEM DESCRIPTION)

RECORD DATA PROVIDED BY BLUE OX LAND SERVICES

SERENOA VILLAGE 3 PHASE 2 "RECORD DRAWINGS"

WETLAND #3 EL. 114.7

WETLAND #2 EL. 114.7

WETLAND #1 EL. 114.7

WETLAND BUFFER COMPENSATION (3,646 SF)

WETLAND BUFFER ENCROACHMENT (5,468 SF)

WETLAND BUFFER ENCROACHMENT (8,861 SF)

WETLAND BUFFER COMPENSATION (120 SF)

WETLAND #2

WETLAND #1

WETLAND #3

WETLAND #4

WETLAND #5

WETLAND #863


WETLAND #864

WETLAND #865

WETLAND #866

WETLAND #867

WETLAND #868</

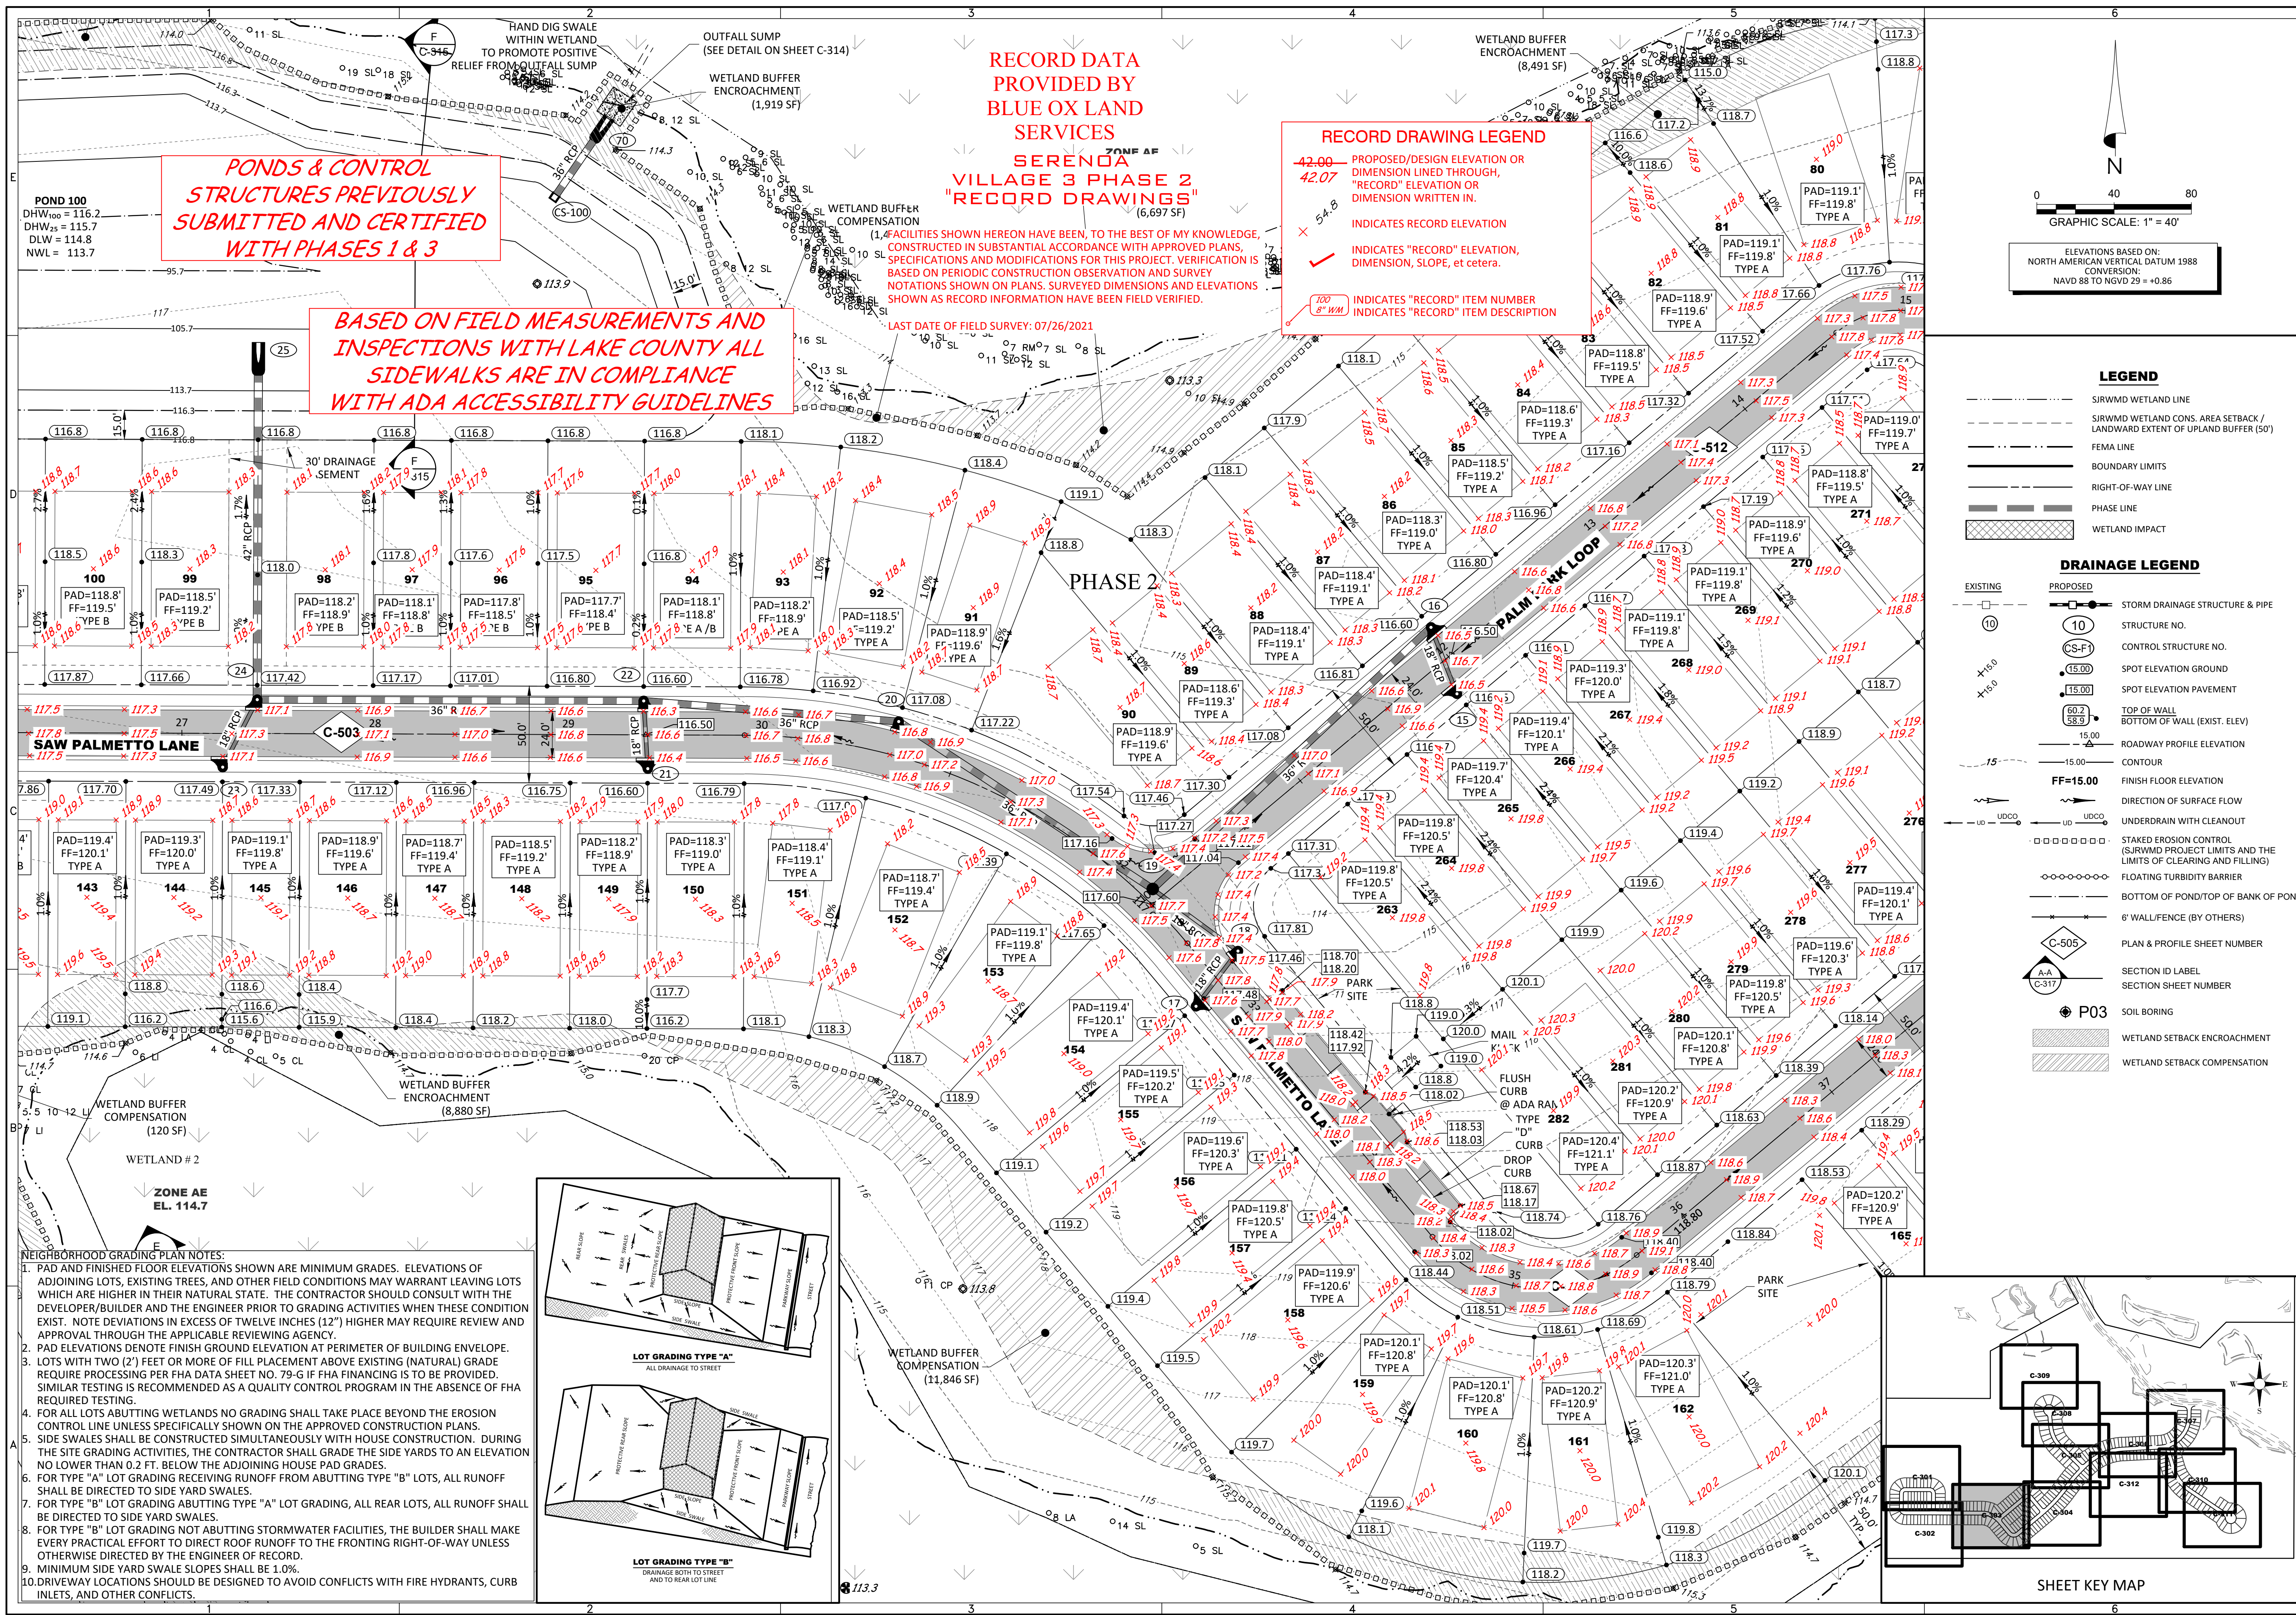

PONDS & CONTROL STRUCTURES PREVIOUSLY SUBMITTED AND CERTIFIED WITH PHASES 1 & 3

BASED ON FIELD MEASUREMENTS AND INSPECTIONS WITH LAKE COUNTY ALL SIDEWALKS ARE IN COMPLIANCE WITH ADA ACCESSIBILITY GUIDELINES

RECORD DATA PROVIDED BY BLUE OX LAND SERVICES

SERENOA VILLAGE 3 PHASE 2 "RECORD DRAWINGS" (6,697 SF)

RECORD DRAWING LEGEND

- 42.00 - PROPOSED/DESIGN ELEVATION OR DIMENSION LINED THROUGH, "RECORD" ELEVATION OR DIMENSION WRITTEN IN.
- 54.8 - INDICATES RECORD ELEVATION
- INDICATES "RECORD" ELEVATION, DIMENSION, SLOPE, et cetera.
- INDICATES "RECORD" ITEM NUMBER
- INDICATES "RECORD" ITEM DESCRIPTION

ELEVATIONS BASED ON:
NORTH AMERICAN VERTICAL DATUM 1988
CONVERSION:
NAVD 88 TO NGVD 29 = +0.86

LEGEND



- SIRWMD WETLAND LINE
- SIRWMD WETLAND CONS. AREA SETBACK / LANDWARD EXTENT OF UPLAND BUFFER (50')
- FEMA LINE
- BOUNDARY LIMITS
- RIGHT-OF-WAY LINE
- PHASE LINE
- WETLAND IMPACT

DRAINAGE LEGEND

- EXISTING
- PROPOSED
- STORM DRAINAGE STRUCTURE & PIPE
- STRUCTURE NO.
- CONTROL STRUCTURE NO.
- SPOT ELEVATION GROUND
- SPOT ELEVATION PAVEMENT
- TOP OF WALL
- BOTTOM OF WALL (EXIST. ELEV)
- ROADWAY PROFILE ELEVATION
- CONTOUR
- FF=15.00
- FINISH FLOOR ELEVATION
- DIRECTION OF SURFACE FLOW
- UNDERDRAIN WITH CLEANOUT
- STAKED EROSION CONTROL (SERVING PROJECT LIMITS AND THE LIMITS OF CLEARING AND FILLING)
- FLOATING TURBIDITY BARRIER
- BOTTOM OF POND/TOP OF BANK OF POND
- 6" WALL/FENCE (BY OTHERS)
- PLAN & PROFILE SHEET NUMBER
- SECTION ID LABEL
- SECTION SHEET NUMBER
- SOIL BORING
- WETLAND SETBACK ENCROACHMENT
- WETLAND SETBACK COMPENSATION

NEIGHBORHOOD GRADING PLAN NOTES:

- PAD AND FINISHED FLOOR ELEVATIONS SHOWN ARE MINIMUM GRADES. ELEVATIONS OF ADJOINING LOTS, EXISTING TREES, AND OTHER FIELD CONDITIONS MAY WARRANT LEAVING LOTS WHICH ARE HIGHER IN THEIR NATURAL STATE. THE CONTRACTOR SHOULD CONSULT WITH THE DEVELOPER/BUILDER AND THE ENGINEER PRIOR TO GRADING ACTIVITIES WHEN THIS CONDITION EXISTS. NOTE DEVIATIONS IN EXCESS OF TWELVE INCHES (12") HIGHER MAY REQUIRE REVIEW AND APPROVAL THROUGH THE APPLICABLE REVIEWING AGENCY.
- PAD ELEVATIONS DENOTE FINISH GROUND ELEVATION AT PERIMETER OF BUILDING ENVELOPE.
- LOTS WITH TWO (2) FEET OR MORE OF FILL PLACEMENT ABOVE EXISTING (NATURAL) GRADE REQUIRE PROCESSING PER FHA DATA SHEET NO. 79-G IF FHA FINANCING IS TO BE PROVIDED. SIMILAR TESTING IS RECOMMENDED AS A QUALITY CONTROL PROGRAM IN THE ABSENCE OF FHA REQUIRED TESTING.
- FOR ALL LOTS ABUTTING WETLANDS NO GRADING SHALL TAKE PLACE BEYOND THE EROSION CONTROL LINE UNLESS SPECIFICALLY SHOWN ON THE APPROVED CONSTRUCTION PLANS. SIDE SWALES SHALL BE CONSTRUCTED SIMULTANEOUSLY WITH HOUSE CONSTRUCTION. DURING THE SITE GRADING ACTIVITIES, THE CONTRACTOR SHALL GRADE THE SIDE YARDS TO AN ELEVATION NO LOWER THAN 0.2 FT. BELOW THE ADJOINING HOUSE PAD GRADES.
- FOR TYPE "A" LOT GRADING RECEIVING RUNOFF FROM ABUTTING TYPE "B" LOTS, ALL RUNOFF SHALL BE DIRECTED TO SIDE YARD SWALES.
- FOR TYPE "B" LOT GRADING ABUTTING TYPE "A" LOT GRADING, ALL REAR LOTS, ALL RUNOFF SHALL BE DIRECTED TO SIDE YARD SWALES.
- FOR TYPE "B" LOT GRADING NOT ABUTTING STORMWATER FACILITIES, THE BUILDER SHALL MAKE EVERY PRACTICAL EFFORT TO DIRECT ROOF RUNOFF TO THE FRONTING RIGHT-OF-WAY UNLESS OTHERWISE DIRECTED BY THE ENGINEER OF RECORD.
- MINIMUM SIDE YARD SWALE SLOPES SHALL BE 1.0%.
- DRIVEWAY LOCATIONS SHOULD BE DESIGNED TO AVOID CONFLICTS WITH FIRE HYDRANTS, CURB INLETS, AND OTHER CONFLICTS.

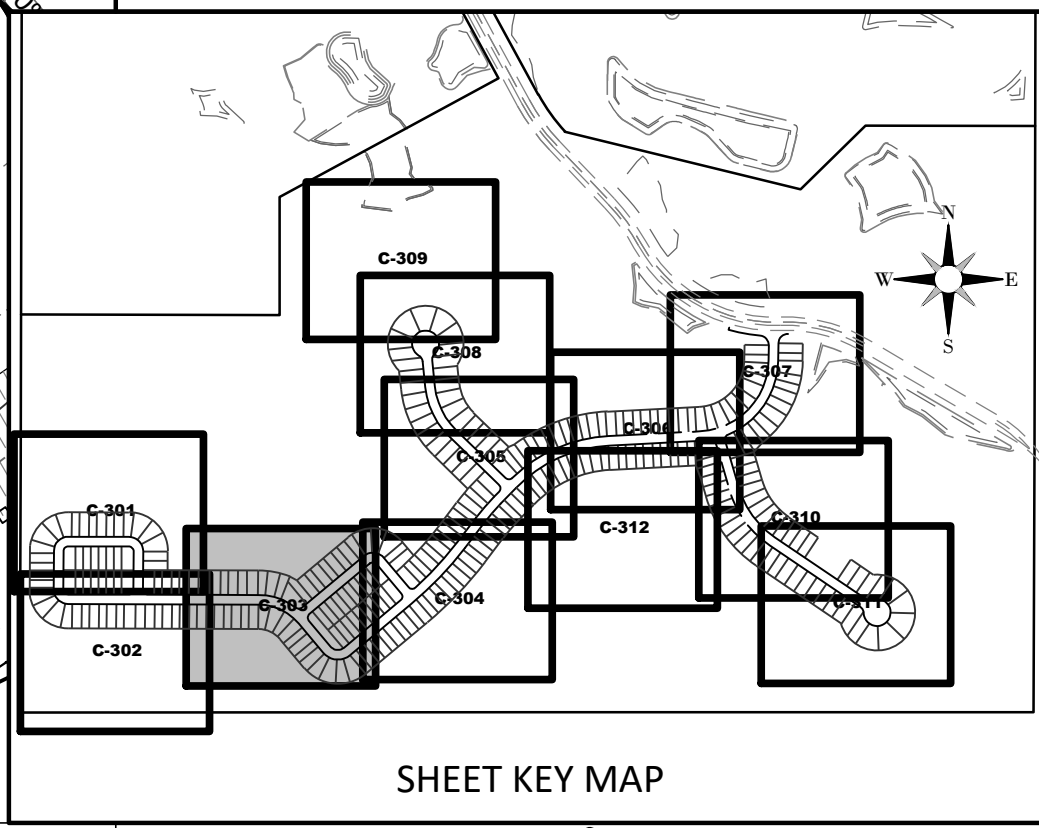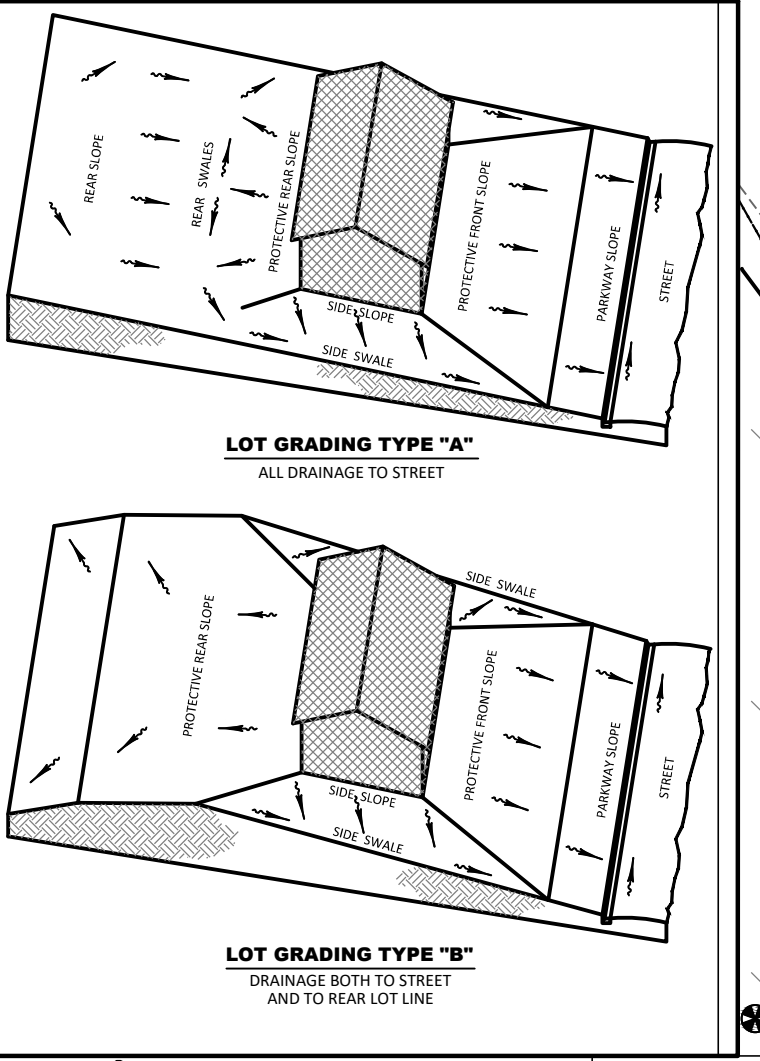

HEIDT DESIGN
Civil Engineering • Planning & GIS
Transportation Engineering
Ecological Services • Landscape Architecture

5904-A Hampton Oaks Pkwy.
Tampa, Florida 33610
Office: 813-253-5311
Fax: 813-464-7629
www.HeidtDesign.com

SERENOA VILLAGE 3 - PHASE 1, 2 & 3
GRADING & DRAINAGE PLAN

PREPARED FOR: **VK AVALON GROVES, LLC**

NO.	DATE	DESCRIPTION
1	02/07/2021	ADDED PH2 RECORD INFORMATION
2	03/08/2021	REV. PAD ELEV./FF GRADING PHASE 2, & REMOVED LOTS 163 & 164
3	05/27/2020	MOVED STR 19
4	03/20/2019	REV. WETLANDS MAP, LOTS & GRADES
5	11/13/2019	REV. PARKING GRADES
6	11/08/2019	REVISED SUBMITTAL

PROJECT NO.: KLP-AG-1089
FILE: GD-REC
DESIGN BY: FRANCIS
DRAWN BY: JLOAIZA

STATE OF FLORIDA
PROFESSIONAL ENGINEER



Timothy M. Plate, State of Florida,
Professional Engineer, License No. 41153

This item has been digitally
signed and sealed by
Timothy M. Plate, P.E. on the date
indicated here.

Printed copies of this document
are not considered signed and
sealed and the signature must be
verified on any electronic copies.

TIMOTHY M. PLATE, P.E.
DATE: _____
LICENSE NO. 41153

C-303

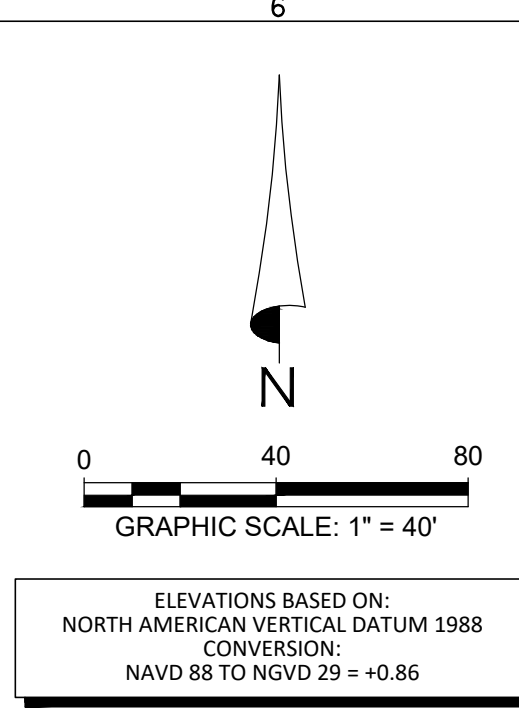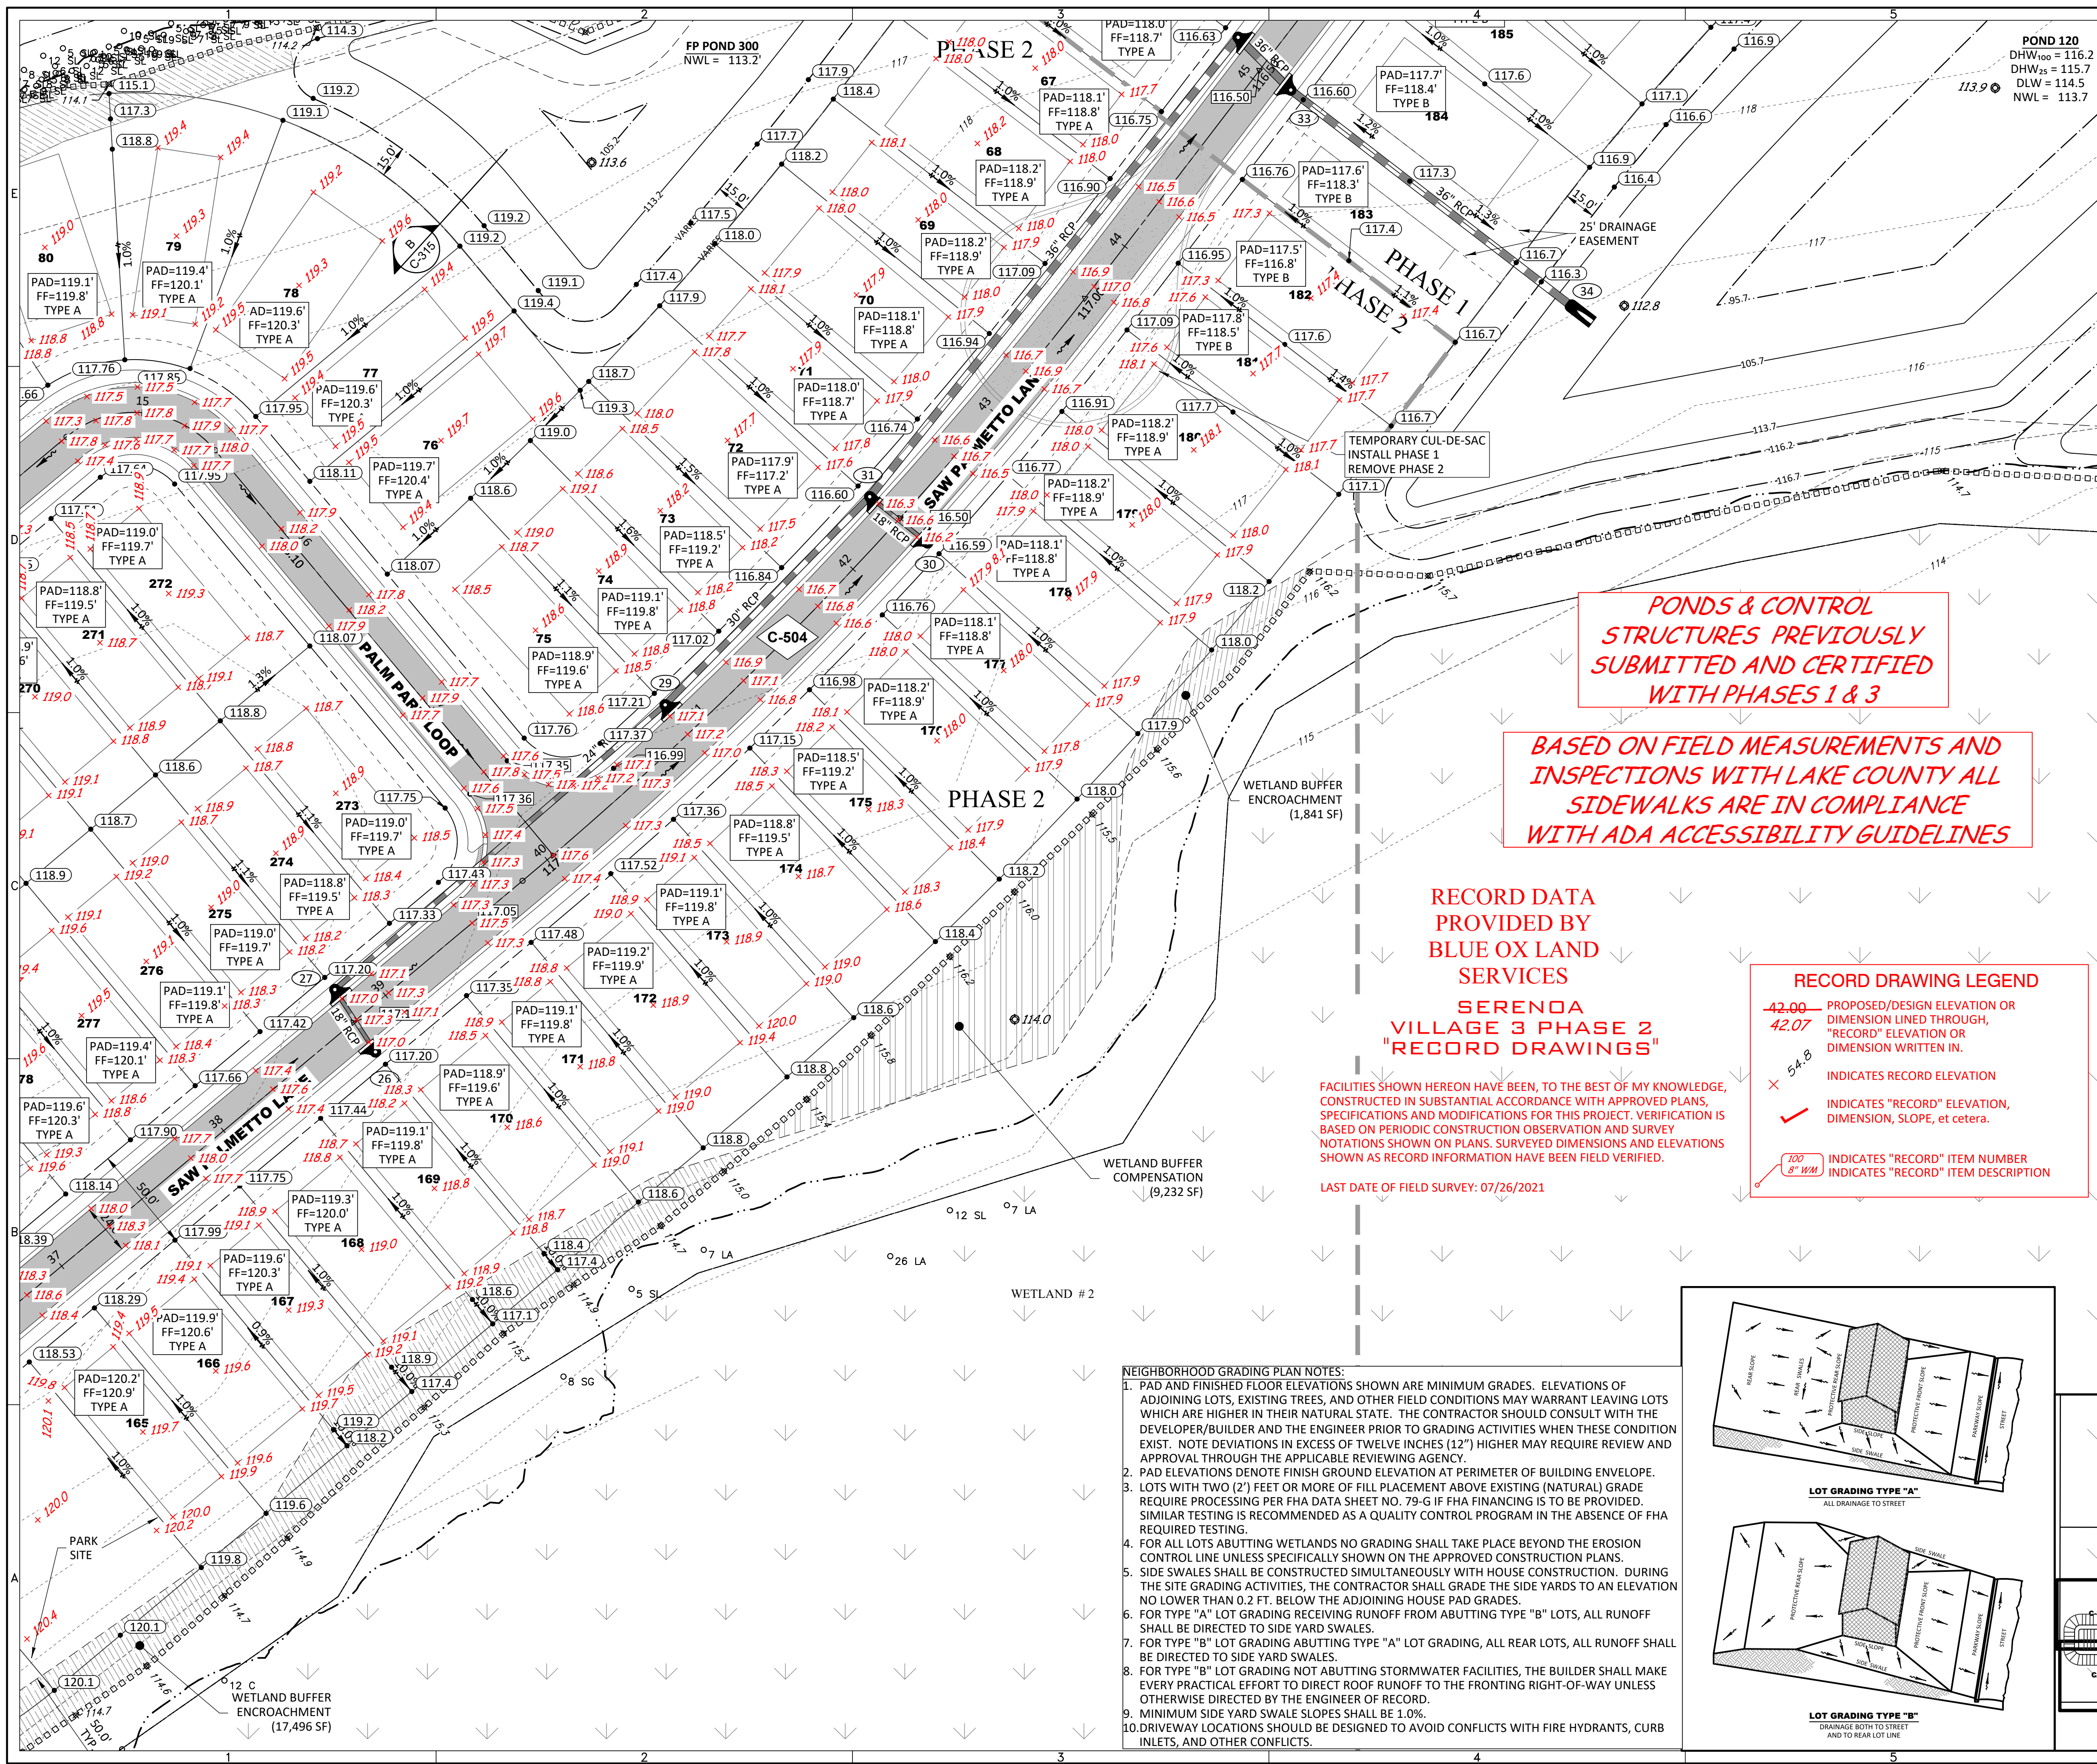

LEGEND

- SIRWMD WETLAND LINE
- SIRWMD WETLAND CONS. AREA SETBACK / LANDWARD EXTENT OF UPLAND BUFFER (50')
- FEMA LINE
- BOUNDARY LIMITS
- RIGHT-OF-WAY LINE
- PHASE LINE
- WETLAND IMPACT

DRAINAGE LEGEND

EXISTING	PROPOSED	DESCRIPTION
(10)	(10)	STORM DRAINAGE STRUCTURE & PIPE STRUCTURE NO.
(C-S-F)	(C-S-F)	CONTROL STRUCTURE NO.
(15.00)	(15.00)	SPOT ELEVATION GROUND
(15.00)	(15.00)	SPOT ELEVATION PAVEMENT
(60.2 / 58.9)	(60.2 / 58.9)	TOP OF WALL / BOTTOM OF WALL (EXIST. ELEV)
(15.00)	(15.00)	ROADWAY PROFILE ELEVATION
(15)	(15)	CONTOUR
	FF=15.00	FINISH FLOOR ELEVATION
		DIRECTION OF SURFACE FLOW
		UNDERDRAIN WITH CLEANOUT
		STAKED EROSION CONTROL (SIRWMD PROJECT LIMITS AND THE LIMITS OF CLEARING AND FILLING)
		FLOATING TURBIDITY BARRIER
		BOTTOM OF POND/TOP OF BANK OF POND
		6' WALL/FENCE (BY OTHERS)
		PLAN & PROFILE SHEET NUMBER
		SECTION ID LABEL
		SECTION SHEET NUMBER
		SOIL BORING
		WETLAND SETBACK ENCROACHMENT
		WETLAND SETBACK COMPENSATION

PONDS & CONTROL STRUCTURES PREVIOUSLY SUBMITTED AND CERTIFIED WITH PHASES 1 & 3

BASED ON FIELD MEASUREMENTS AND INSPECTIONS WITH LAKE COUNTY ALL SIDEWALKS ARE IN COMPLIANCE WITH ADA ACCESSIBILITY GUIDELINES

RECORD DATA PROVIDED BY BLUE OX LAND SERVICES SERENOA VILLAGE 3 PHASE 2 "RECORD DRAWINGS"



FACILITIES SHOWN HEREON HAVE BEEN, TO THE BEST OF MY KNOWLEDGE, CONSTRUCTED IN SUBSTANTIAL ACCORDANCE WITH APPROVED PLANS, SPECIFICATIONS AND MODIFICATIONS FOR THIS PROJECT. VERIFICATION IS BASED ON PERIODIC CONSTRUCTION OBSERVATION AND SURVEY NOTATIONS SHOWN ON PLANS. SURVEYED DIMENSIONS AND ELEVATIONS NOTAS AS RECORD INFORMATION HAVE BEEN FIELD VERIFIED.

LAST DATE OF FIELD SURVEY: 07/26/2021

RECORD DRAWING LEGEND

- 42.00 PROPOSED/DESIGN ELEVATION OR DIMENSION LINED THROUGH, "RECORD" ELEVATION OR DIMENSION WRITTEN IN.
- 42.07 "RECORD" ELEVATION OR DIMENSION WRITTEN IN.
- 5-4.8 INDICATES RECORD ELEVATION
- INDICATES "RECORD" ELEVATION, DIMENSION, SLOPE, et cetera.
- INDICATES "RECORD" ITEM NUMBER
- INDICATES "RECORD" ITEM DESCRIPTION

- NEIGHBORHOOD GRADING PLAN NOTES:**
- PAD AND FINISHED FLOOR ELEVATIONS SHOWN ARE MINIMUM GRADES. ELEVATIONS OF ADJOINING LOTS, EXISTING TREES, AND OTHER FIELD CONDITIONS MAY WARRANT LEAVING LOTS WHICH ARE HIGHER IN THEIR NATURAL STATE. THE CONTRACTOR SHOULD CONSULT WITH THE DEVELOPER/BUILDER AND THE ENGINEER PRIOR TO GRADING ACTIVITIES WHEN THESE CONDITIONS EXIST. NOTE DEVIATIONS IN EXCESS OF TWELVE INCHES (12") HIGHER MAY REQUIRE REVIEW AND APPROVAL THROUGH THE APPLICABLE REVIEWING AGENCY.
 - PAD ELEVATIONS DENOTE FINISH GROUND ELEVATION AT PERIMETER OF BUILDING ENVELOPE.
 - LOTS WITH TWO (2') FEET OR MORE OF FILL PLACEMENT ABOVE EXISTING (NATURAL) GRADE REQUIRE PROCESSING PER FHA DATA SHEET NO. 79-G IF FHA FINANCING IS TO BE PROVIDED. SIMILAR TESTING IS RECOMMENDED AS A QUALITY CONTROL PROGRAM IN THE ABSENCE OF FHA REQUIRED TESTING.
 - FOR ALL LOTS ABUTTING WETLANDS NO GRADING SHALL TAKE PLACE BEYOND THE EROSION CONTROL LINE UNLESS SPECIFICALLY SHOWN ON THE APPROVED CONSTRUCTION PLANS.
 - SIDE SWALES SHALL BE CONSTRUCTED SIMULTANEOUSLY WITH HOUSE CONSTRUCTION. DURING THE SITE GRADING ACTIVITIES, THE CONTRACTOR SHALL GRADE THE SIDE YARDS TO AN ELEVATION NO LOWER THAN 0.2 FT. BELOW THE ADJOINING HOUSE PAD GRADES.
 - FOR TYPE "A" LOT GRADING RECEIVING RUNOFF FROM ABUTTING TYPE "B" LOTS, ALL RUNOFF SHALL BE DIRECTED TO SIDE YARD SWALES.
 - FOR TYPE "B" LOT GRADING ABUTTING TYPE "A" LOT GRADING, ALL REAR LOTS, ALL RUNOFF SHALL BE DIRECTED TO SIDE YARD SWALES.
 - FOR TYPE "B" LOT GRADING NOT ABUTTING STORMWATER FACILITIES, THE BUILDER SHALL MAKE EVERY PRACTICAL EFFORT TO DIRECT ROOF RUNOFF TO THE FRONTING RIGHT-OF-WAY UNLESS OTHERWISE DIRECTED BY THE ENGINEER OF RECORD.
 - MINIMUM SIDE YARD SWALE SLOPES SHALL BE 1.0%.
 - DRIVEWAY LOCATIONS SHOULD BE DESIGNED TO AVOID CONFLICTS WITH FIRE HYDRANTS, CURB INLETS, AND OTHER CONFLICTS.

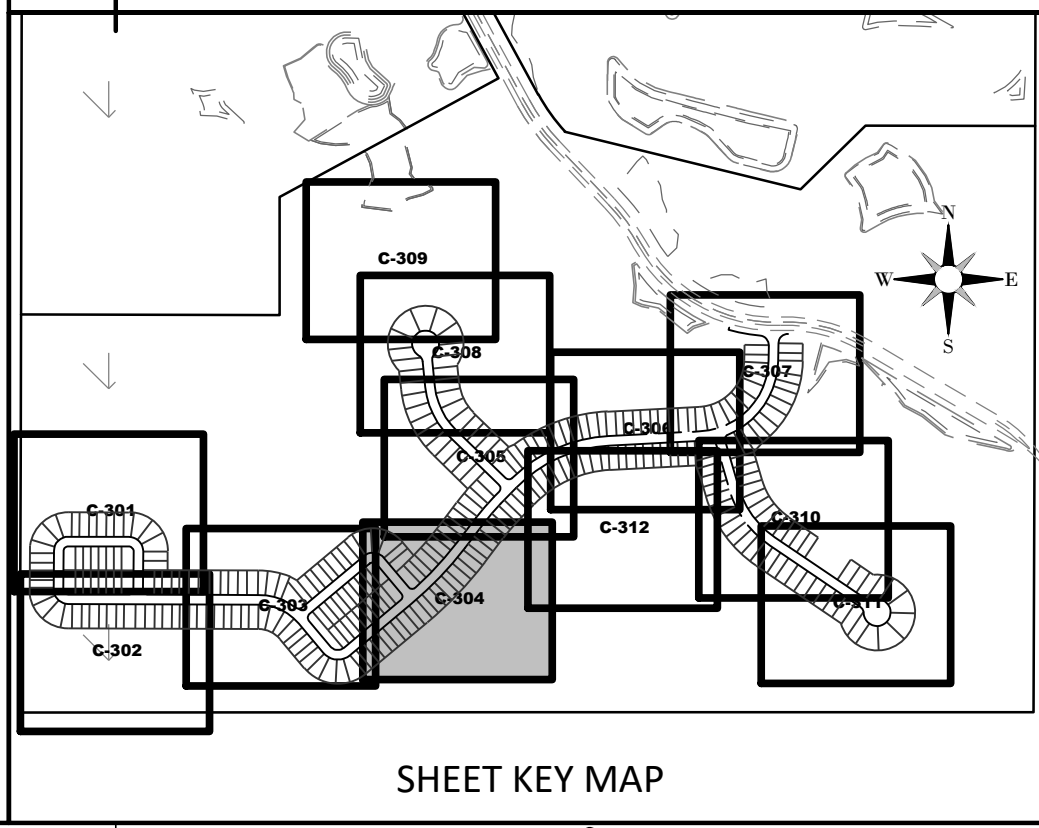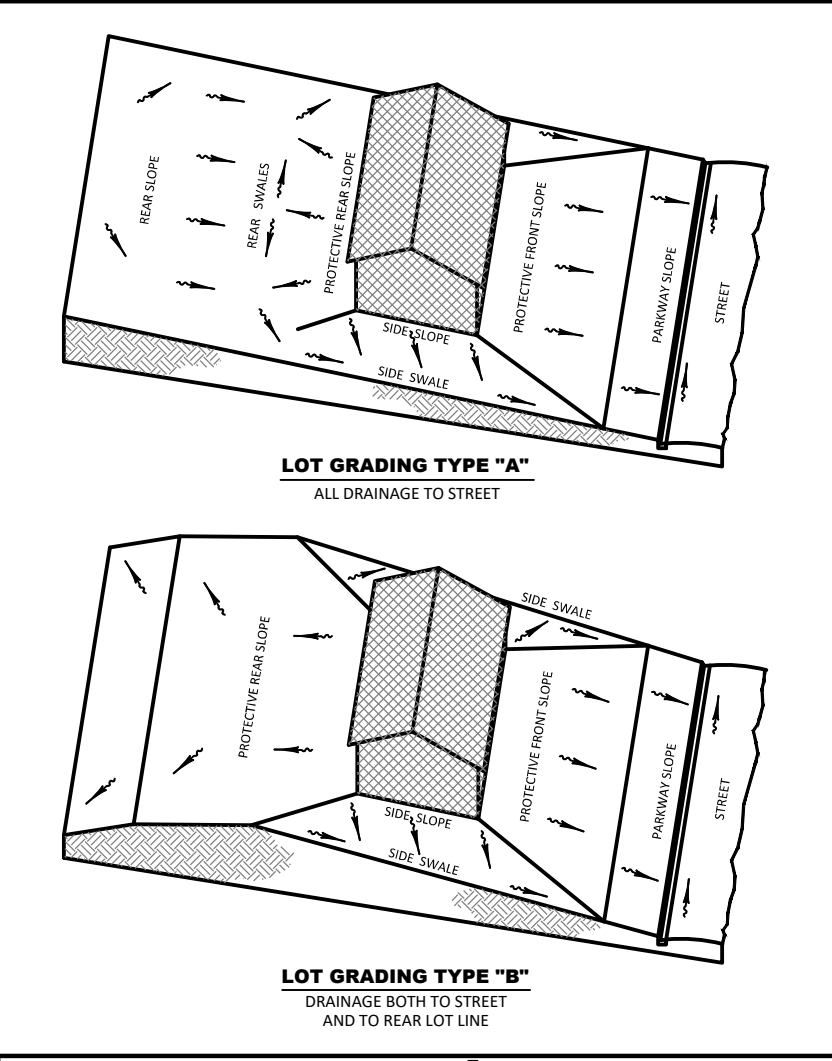

HEIDT DESIGN
Civil Engineering • Planning & GIS
Transportation Engineering
Ecological Services • Landscape Architecture

5904-A Hampton Oaks Pkwy.
Tampa, Florida 33610
Office: 813-253-5311
Fax: 813-464-7629
www.HeidtDesign.com

SERENOA VILLAGE 3 - PHASE 1, 2 & 3 GRADING & DRAINAGE PLAN

PREPARED FOR: **VK AVALON GROVES, LLC**

NO.	DATE	DESCRIPTION
1	02/07/2021	ADDED PH2 RECORD INFORMATION

REV.	DATE	DESCRIPTION
12	11/15/2021	REV. LABEL POSITION TO SHOW GRADE - LOTS 181, 182 & 183
9	3/08/2021	REV. PAD ELEV./FF GRADES PHASE 2, & REMOVED LOTS 163 & 164
3	05/27/2020	REV. WETLANDS IMP. LOTS & GRADES & REMOVED STR 28
2	03/20/2020	REV. WETLANDS IMP. LOTS & GRADES
1	11/08/2019	REVISED SUBMITTAL

PROJECT NO: KLP-AG-1089
FILE: GD-REF
DESIGN BY: FRANCIS
DRAWN BY: JLOAIZA

STATE OF FLORIDA
PROFESSIONAL ENGINEER


Timothy M. Plate, State of Florida, Professional Engineer, License No. 41153

This item has been digitally signed and sealed by Timothy M. Plate, P.E. on the date indicated herein.

Printed copies of this document are not considered signed and sealed and the signature must be verified on any electronic copies.



TIMOTHY M. PLATE, P.E.
DATE: _____
LICENSE NO. 41153

C-304

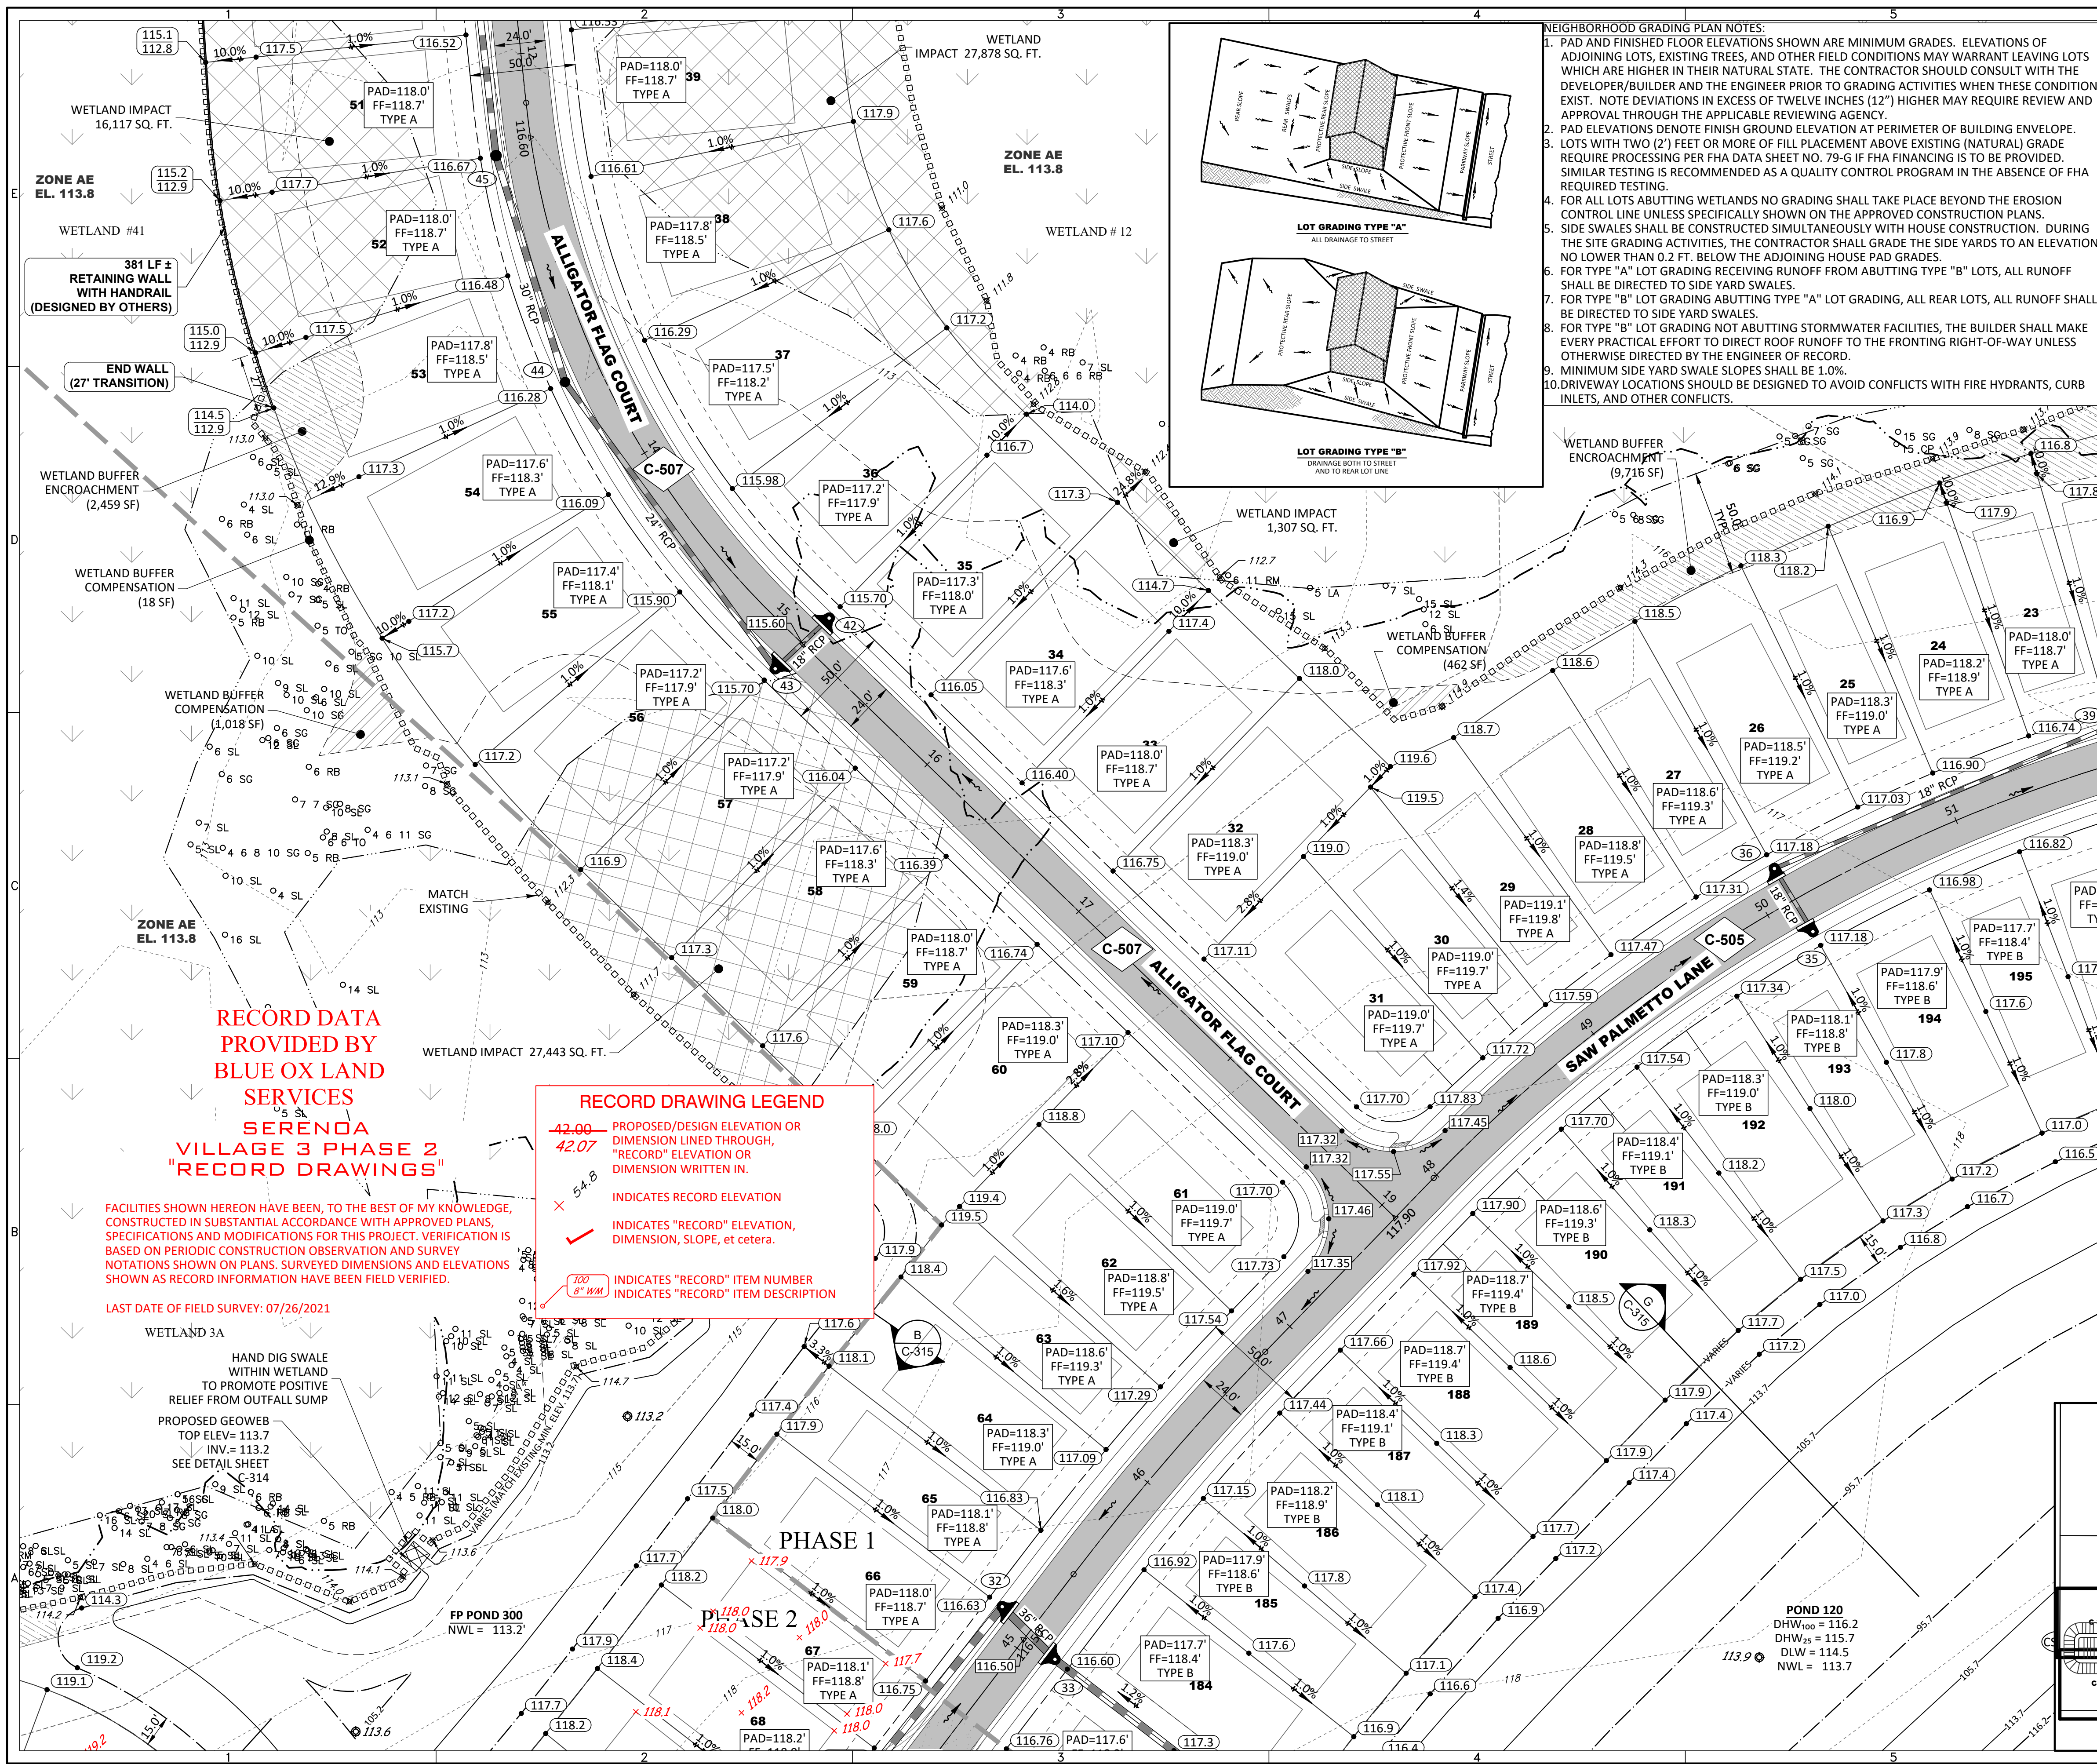

NEIGHBORHOOD GRADING PLAN NOTES:

- PAD AND FINISHED FLOOR ELEVATIONS SHOWN ARE MINIMUM GRADES. ELEVATIONS OF ADJOINING LOTS, EXISTING TREES, AND OTHER FIELD CONDITIONS MAY WARRANT LEAVING LOTS WHICH ARE HIGHER IN THEIR NATURAL STATE. THE CONTRACTOR SHOULD CONSULT WITH THE DEVELOPER/BUILDER AND THE ENGINEER PRIOR TO GRADING ACTIVITIES WHEN THESE CONDITIONS EXIST. NOTE DEVIATIONS IN EXCESS OF TWELVE INCHES (12") HIGHER MAY REQUIRE REVIEW AND APPROVAL THROUGH THE APPLICABLE REVIEWING AGENCY.
- PAD ELEVATIONS DENOTE FINISH GROUND ELEVATION AT PERIMETER OF BUILDING ENVELOPE. LOTS WITH TWO (2) FEET OR MORE OF FILL PLACEMENT ABOVE EXISTING (NATURAL) GRADE REQUIRE PROCESSING PER FHA DATA SHEET NO. 79-G IF FHA FINANCING IS TO BE PROVIDED. SIMILAR TESTING IS RECOMMENDED AS A QUALITY CONTROL PROGRAM IN THE ABSENCE OF FHA REQUIRED TESTING.
- FOR ALL LOTS ABUTTING WETLANDS NO GRADING SHALL TAKE PLACE BEYOND THE EROSION CONTROL LINE UNLESS SPECIFICALLY SHOWN ON THE APPROVED CONSTRUCTION PLANS.
- SIDE SWALES SHALL BE CONSTRUCTED SIMULTANEOUSLY WITH HOUSE CONSTRUCTION. DURING THE SITE GRADING ACTIVITIES, THE CONTRACTOR SHALL GRADE THE SIDE YARDS TO AN ELEVATION NO LOWER THAN 0.2 FT. BELOW THE ADJOINING HOUSE PAD GRADES.
- FOR TYPE "A" LOT GRADING RECEIVING RUNOFF FROM ABUTTING TYPE "B" LOTS, ALL RUNOFF SHALL BE DIRECTED TO SIDE YARD SWALES.
- FOR TYPE "B" LOT GRADING ABUTTING TYPE "A" LOT GRADING, ALL REAR LOTS, ALL RUNOFF SHALL BE DIRECTED TO SIDE YARD SWALES.
- FOR TYPE "B" LOT GRADING NOT ABUTTING STORMWATER FACILITIES, THE BUILDER SHALL MAKE EVERY PRACTICAL EFFORT TO DIRECT ROOF RUNOFF TO THE FRONTING RIGHT-OF-WAY UNLESS OTHERWISE DIRECTED BY THE ENGINEER OF RECORD.
- MINIMUM SIDE YARD SWALE SLOPES SHALL BE 1.0%.
- DRIVEWAY LOCATIONS SHOULD BE DESIGNED TO AVOID CONFLICTS WITH FIRE HYDRANTS, CURB INLETS, AND OTHER CONFLICTS.

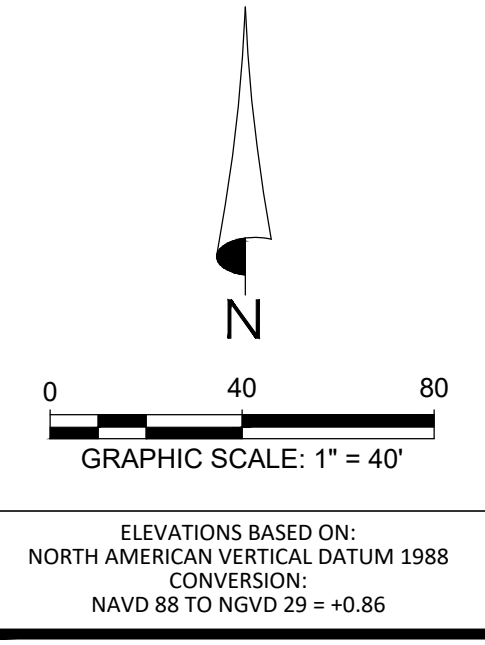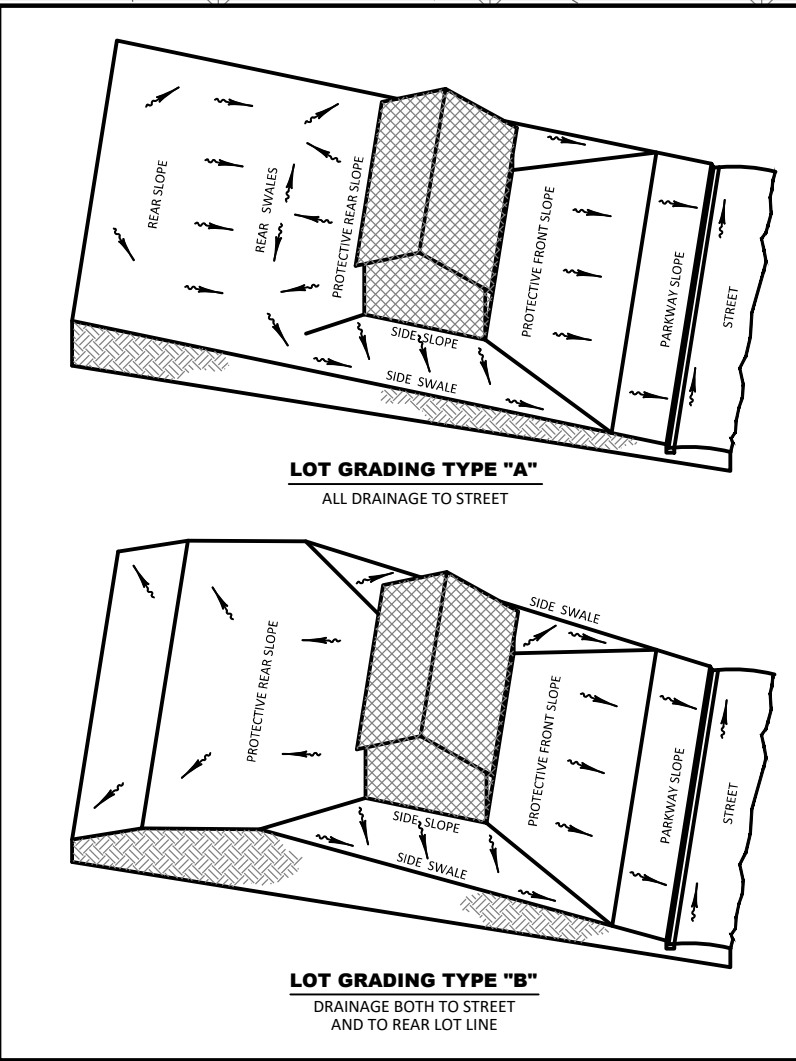

LEGEND

- SIRWMD WETLAND LINE
- SIRWMD WETLAND CONS. AREA SETBACK / LANDWARD EXTENT OF UPLAND BUFFER (50')
- FEMA LINE
- BOUNDARY LIMITS
- RIGHT-OF-WAY LINE
- PHASE LINE
- WETLAND IMPACT

DRAINAGE LEGEND

- EXISTING: 10 (Structure No.), 15.00 (Spot Elevation), 60.2 (Top of Wall), 55.9 (Bottom of Wall), 15.00 (Roadway Profile), 15.00 (Contour), FF=15.00 (Finish Floor), UDDCO (Underdrain), Staked Erosion Control, Floating Turbidity Barrier, Bottom of Pond/Top of Bank of Pond, 6' Wall/Fence, Plan & Profile Sheet Number, Section ID Label, Section Sheet Number, P03 (Soil Boring), Wetland Setback Encroachment, Wetland Setback Compensation
- PROPOSED: 10 (Structure No.), C-S-F (Control Structure No.), 15.00 (Spot Elevation), 60.2 (Top of Wall), 55.9 (Bottom of Wall), 15.00 (Roadway Profile), FF=15.00 (Finish Floor), UDDCO (Underdrain), Staked Erosion Control, Floating Turbidity Barrier, Bottom of Pond/Top of Bank of Pond, 6' Wall/Fence, Plan & Profile Sheet Number, Section ID Label, Section Sheet Number, P03 (Soil Boring), Wetland Setback Encroachment, Wetland Setback Compensation


RECORD DATA PROVIDED BY BLUE OX LAND SERVICES
SERENOA VILLAGE 3 PHASE 2 "RECORD DRAWINGS"

RECORD DRAWING LEGEND

- 42.00 - PROPOSED/DESIGN ELEVATION OR DIMENSION LINED THROUGH, "RECORD" ELEVATION OR DIMENSION WRITTEN IN.
- 54.8 - INDICATES RECORD ELEVATION
- ✓ - INDICATES "RECORD" ELEVATION, DIMENSION, SLOPE, et cetera.
- 103 (8" W) - INDICATES "RECORD" ITEM NUMBER
- INDICATES "RECORD" ITEM DESCRIPTION

FACILITIES SHOWN HEREON HAVE BEEN, TO THE BEST OF MY KNOWLEDGE, CONSTRUCTED IN SUBSTANTIAL ACCORDANCE WITH APPROVED PLANS, SPECIFICATIONS AND MODIFICATIONS FOR THIS PROJECT. VERIFICATION IS BASED ON PERIODIC CONSTRUCTION OBSERVATION AND SURVEY NOTATIONS SHOWN ON PLANS. SURVEYED DIMENSIONS AND ELEVATIONS SHOWN AS RECORD INFORMATION HAVE BEEN FIELD VERIFIED.

LAST DATE OF FIELD SURVEY: 07/26/2021

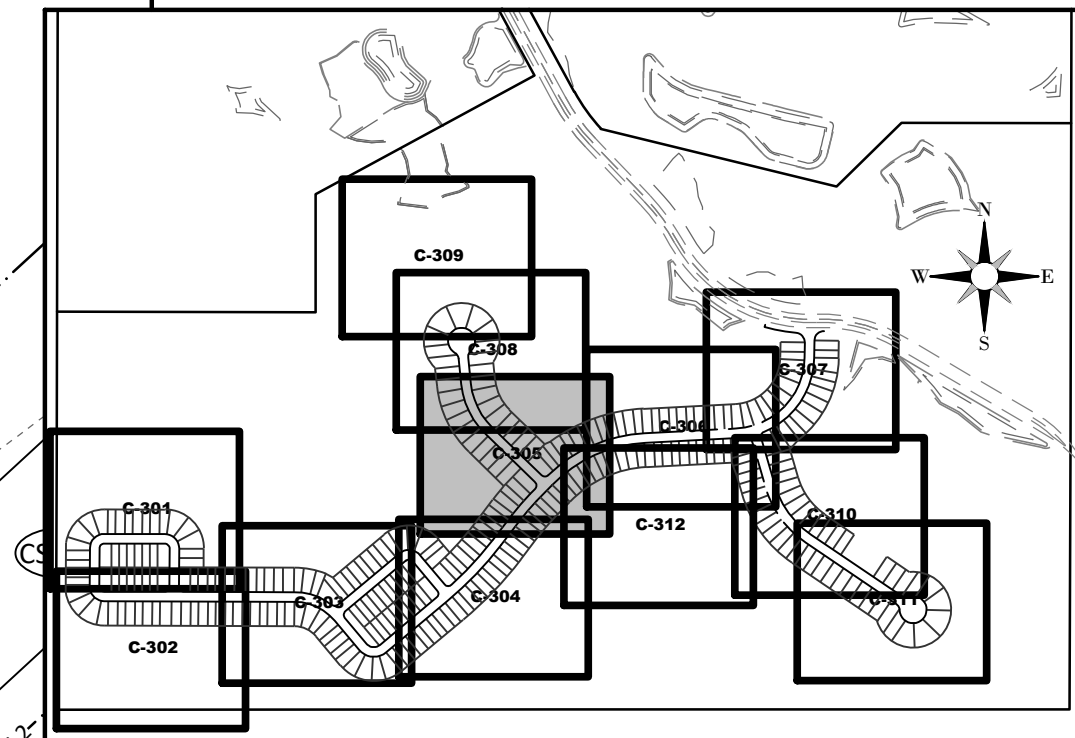

HEIDT DESIGN
 Civil Engineering • Planning & GIS
 Transportation Engineering
 Ecological Services • Landscape Architecture

5904-A Hampton Oaks Pkwy.
 Tampa, Florida 33610
 Office: 813-253-5311
 Fax: 813-464-7629
 www.HeidtDesign.com

SERENOA VILLAGE 3 - PHASE 1, 2 & 3
GRADING & DRAINAGE PLAN

PREPARED FOR: **VK AVALON GROVES, LLC**

NO.	DATE	DESCRIPTION
1	03/08/2021	REV. PAD ELEV./FF GRADINGS PHASE 2
2	03/20/2021	REV. WETLANDS MAP, LOTS & GRADINGS
3	11/08/2021	REVISION SUBMITTAL

PROJECT NO.: KLP-AG-1089
 FILE: GD-REC
 DESIGN BY: FRANCIS
 DRAWN BY: JLOAIZA

STATE OF FLORIDA
 PROFESSIONAL ENGINEER

Timothy M. Plate, State of Florida, Professional Engineer, License No. 41153

This item has been digitally signed and sealed by Timothy M. Plate, P.E. on the date indicated here.

Printed copies of this document are not considered signed and sealed and the signature must be verified on any electronic copies.

TIMOTHY M. PLATE, P.E.
 DATE: _____
 LICENSE NO. 41153

C-305

R:\AVALON GROVES\VILLAGE 3\ENGINEERING\RECORD\PHASE 2\GD-REC-305-20210716 12:57 PM ALCIA SIKES

STRUCTURE TABLE			
STR. NO.	STR. TYPE	TOP ELEV.	COMMENTS
1	FDOT TYPE 3 CURB INLET	117.78 118.07	PHASE 2
2	FDOT TYPE 3 CURB INLET	117.75 118.02	PHASE 2
3	TYPE P MANHOLE 4'-0" DIA.	117.64 117.02	PHASE 2
4	TYPE P MANHOLE 4'-0" DIA.	117.44 116.93	PHASE 2
5	FDOT TYPE 4 CURB INLET	116.85 116.89	PHASE 2
6	FDOT TYPE 3 CURB INLET	116.85 117.10	PHASE 2
7	TYPE P MANHOLE 4'-0" DIA.	117.24 117.18	PHASE 2
8	FDOT TYPE 4 CURB INLET	116.85 116.95	PHASE 2
9	FDOT TYPE 3 CURB INLET	116.85 116.97	PHASE 2
10	TYPE J MANHOLE 6'-0" DIA.	117.52 117.43	PHASE 2
11	FDOT TYPE 4 CURB INLET	117.55 117.72	PHASE 2
12	TYPE J MANHOLE 6'-0" DIA.	118.05 117.91	PHASE 2
13	TYPE J MANHOLE 6'-0" DIA.	116.75 116.96	PHASE 2
14	MES 42" RCP		PHASE 2
15	FDOT TYPE 4 CURB INLET	116.55 116.93	PHASE 2
16	FDOT TYPE 4 CURB INLET	116.55 116.89	PHASE 2
17	FDOT TYPE 4 CURB INLET	117.83 118.15	PHASE 2
18	FDOT TYPE 3 CURB INLET	117.81 117.94	PHASE 2
19	TYPE J MANHOLE 5'-0" DIA.	117.50 117.64	PHASE 2
20	FDOT TYPE 3 CURB INLET	117.06 117.26	PHASE 2

PIPE TABLE							
START STR.	END STR.	PIPE DIMENSION & MATERIAL	LENGTH	SLOPE	START INV.	END INV.	FALL IN FEET
1	2	18" RCP	36	0.27% 0.28%	113.60 113.25	113.50 113.15	0.10
2	3	18" RCP	166	0.24% 0.27%	113.50 113.10	113.10 112.65	0.40
3	4	18" RCP	33	0.60% 0.30%	113.10 112.63	112.90 112.53	0.20
4	6	18" RCP	49	0.41% 0.48%	112.90 112.50	112.70 112.26	0.20
5	6	24" RCP	35	0.29% 0.71%	112.20 112.18	112.10 111.93	0.10
6	7	30" RCP	171	0.18% 0.60%	111.60 111.21	111.30 110.18	0.30
7	10	30" RCP	32	0.31% 0.28%	109.70 109.78	109.60 109.69	0.10
8	9	24" RCP	35	0.29% 0.14%	112.20 111.91	112.10 111.81	0.10
9	10	30" RCP	329	0.09% 0.14%	111.60 111.25	111.30 110.80	0.30
10	11	36" RCP	45	0.23% 0.32%	109.60 109.64	109.50 109.50	0.10
11	12	42" RCP	142	0.07% 0.08%	107.30 107.31	107.20 107.11	0.10
12	13	42" RCP	117	0.09% 0.09%	107.20 107.18	107.10 107.08	0.10
13	14	42" RCP	29	0.34% 0.26%	107.10 107.08	107.00 107.00	0.10
15	16	18" RCP	37	0.27% 0.22%	112.40 112.50	112.30 112.42	0.10
16	19	36" RCP	198	0.05% 0.05%	109.50 109.95	109.40 109.85	0.10
17	18	18" RCP	36	0.28% 0.25%	113.70 113.50	113.60 113.41	0.10
18	19	18" RCP	55	0.18% 0.17%	111.00 111.20	110.90 111.10	0.10
19	20	36" RCP	157	0.13% 0.42%	109.40 109.85	109.20 109.85	0.20
20	22	36" RCP	132	0.15% 0.15%	109.20 109.20	109.00 109.00	0.20
21	22	18" RCP	35	0.28% 0.23%	112.50 112.34	112.40 112.26	0.10

STRUCTURE TABLE			
STR. NO.	STR. TYPE	TOP ELEV.	COMMENTS
21	FDOT TYPE 4 CURB INLET	116.55 116.69	PHASE 2
22	FDOT TYPE 3 CURB INLET	116.55 116.72	PHASE 2
23	FDOT TYPE 3 CURB INLET	117.45 117.56	PHASE 2
24	FDOT TYPE 3 CURB INLET	117.39 117.51	PHASE 2
25	MES 42" RCP		PHASE 2
26	FDOT TYPE 3 CURB INLET	117.45 117.42	PHASE 2
27	FDOT TYPE 4 CURB INLET	117.45 117.46	PHASE 2
29	FDOT TYPE 4 CURB INLET	117.47 117.40	PHASE 2
30	FDOT TYPE 4 CURB INLET	116.55 116.68	PHASE 2
31	FDOT TYPE 3 CURB INLET	116.55 116.65	PHASE 2
32	FDOT TYPE 4 CURB INLET	116.55	PHASE 1
33	FDOT TYPE 4 CURB INLET	116.55	PHASE 1
34	MES 36" RCP		PHASE 1
35	FDOT TYPE 3 CURB INLET	117.19	PHASE 1
36	FDOT TYPE 3 CURB INLET	117.19	PHASE 1
37	FDOT TYPE 3 CURB INLET	117.16	PHASE 1
38	FDOT TYPE 3 CURB INLET	117.14	PHASE 1
39	FDOT TYPE 4 CURB INLET	116.55	PHASE 1
40	FDOT TYPE 4 CURB INLET	116.55	PHASE 1
41	MES 30" RCP		PHASE 1

PIPE TABLE							
START STR.	END STR.	PIPE DIMENSION & MATERIAL	LENGTH	SLOPE	START INV.	END INV.	FALL IN FEET
22	24	36" RCP	200	0.10%	109.00 109.00	108.80	0.20
23	24	18" RCP	39	0.25%	113.40 113.35	113.20 113.25	0.10
24	25	42" RCP	170	0.18% 0.39%	109.70 109.70	109.40 109.00	0.30
26	27	18" RCP	35	0.28% 0.57%	113.00 112.70	112.90 112.50	0.10
27	29	24" RCP	207	0.29% 0.30%	110.40 110.40	109.80 109.78	0.60
29	31	30" RCP	138	0.14% 0.21%	109.80 109.74	109.60 109.45	0.20
30	31	18" RCP	35	0.29% 0.35%	112.50 112.02	112.40 111.90	0.10
31	32	36" RCP	279	0.11%	109.10	108.80	0.30
32	33	36" RCP	35	0.28%	108.80	108.70	0.10
33	34	36" RCP	167	0.12%	108.20	108.00	0.20
35	36	18" RCP	35	0.29%	113.00	112.90	0.10
36	39	18" RCP	173	0.52%	112.90	112.00	0.90
37	38	18" RCP	35	0.28%	113.00	112.90	0.10
38	39	24" RCP	173	0.52%	112.40	111.50	0.90
39	40	24" RCP	36	0.28%	111.50	111.40	0.10
40	41	30" RCP	168	0.12%	108.80	108.60	0.20
42	43	18" RCP	35	0.29%	111.50	111.40	0.10
43	44	24" RCP	168	0.12%	110.90	110.70	0.20
44	45	30" RCP	112	0.18%	110.20	110.00	0.20
45	46	30" RCP	306	0.07%	109.20	109.00	0.20

RECORD DATA PROVIDED BY BLUE OX LAND SERVICES

SERENOA VILLAGE 3 PHASE 2 "RECORD DRAWINGS"

FACILITIES SHOWN HEREON HAVE BEEN, TO THE BEST OF MY KNOWLEDGE, CONSTRUCTED IN SUBSTANTIAL ACCORDANCE WITH APPROVED PLANS, SPECIFICATIONS AND MODIFICATIONS FOR THIS PROJECT. VERIFICATION IS BASED ON PERIODIC CONSTRUCTION OBSERVATION AND SURVEY NOTATIONS SHOWN ON PLANS. SURVEYED DIMENSIONS AND ELEVATIONS SHOWN AS RECORD INFORMATION HAVE BEEN FIELD VERIFIED.

LAST DATE OF FIELD SURVEY: 07/26/2021

RECORD DRAWING LEGEND

~~42.00~~
42.07

PROPOSED/DESIGN ELEVATION OR DIMENSION LINED THROUGH, "RECORD" ELEVATION OR DIMENSION WRITTEN IN.

INDICATES RECORD ELEVATION

INDICATES "RECORD" ELEVATION, DIMENSION, SLOPE, et cetera.

INDICATES "RECORD" ITEM NUMBER

INDICATES "RECORD" ITEM DESCRIPTION

STRUCTURE TABLE			
STR. NO.	STR. TYPE	TOP ELEV.	COMMENTS
49	FDOT TYPE 3 CURB INLET	118.35	PHASE 1
50	TYPE P MANHOLE 4'-0" DIA.	118.04	PHASE 1
51	MES 18" RCP		PHASE 1
52	FDOT TYPE 3 CURB INLET	119.17	PHASE 1
53	FDOT TYPE 3 CURB INLET	119.23	PHASE 1
54	TYPE P MANHOLE 3'-6" DIA.	118.94	PHASE 1
55	MES 18" RCP		PHASE 1
56	FDOT TYPE 4 CURB INLET	117.05	PHASE 1
57	FDOT TYPE 4 CURB INLET	117.05	PHASE 1
58	TYPE P MANHOLE 4'-0" DIA.	116.23	PHASE 1
59	MES 18" RCP		PHASE 1
60	FDOT TYPE 3 CURB INLET	118.29	PHASE 1

PIPE TABLE							
START STR.	END STR.	PIPE DIMENSION & MATERIAL	LENGTH	SLOPE	START INV.	END INV.	FALL IN FEET
46	47-A	36" RCP	142	0.14%	107.70	107.50	0.20
47-A	47	36" RCP	31	0.32%	107.50	107.40	0.10
48	49	18" RCP	35	0.28%	114.20	114.10	0.10
49	50	18" RCP	145	0.21%	111.30	111.00	0.30
50	51	18" RCP	64	0.16%	110.00	109.90	0.10
52	53	18" RCP	37	0.27%	115.00	114.90	0.10
53	54	18" RCP	144	0.21%	112.00	111.70	0.30
54	55	18" RCP	35	0.28%	110.00	109.90	0.10
56	57	18" RCP	35	0.29%	112.70	112.60	0.10
57	58	18" RCP	73	0.27%	110.00	109.80	0.20
58	59	18" RCP	26	0.39%	109.80	109.70	0.10
60	61	18" RCP	35	0.29%	114.10	114.00	0.10
61	62	18" RCP	189	0.16%	114.00	113.70	0.30
62	64	24" RCP	142	0.71%	113.20	112.20	1.00
63	64	18" RCP	36	0.27%	112.80	112.70	0.10
64	66	30" RCP	208	0.34%	111.70	111.00	0.70
65	66	18" RCP	36	0.28%	112.10	112.00	0.10
66	67A	36" RCP	360	0.31%	110.50	109.40	1.10
67	67A	18" RCP	44	0.23%	112.90	112.80	0.10
67A	68	36" RCP	183	0.10%	109.28	109.10	0.18


STRUCTURE TABLE			
STR. NO.	STR. TYPE	TOP ELEV.	COMMENTS
61	FDOT TYPE 3 CURB INLET	118.29	PHASE 1
62	TYPE P MANHOLE 3'-6" DIA.	117.58	PHASE 1
63	FDOT TYPE 3 CURB INLET	117.21	PHASE 1
64	FDOT TYPE 3 CURB INLET	117.25	PHASE 1
65	FDOT TYPE 4 CURB INLET	116.55	PHASE 1
66	FDOT TYPE 4 CURB INLET	116.55	PHASE 1
67	FDOT TYPE 3 CURB INLET	117.65	PHASE 1
67A	FDOT TYPE 3 CURB INLET	117.74	PHASE 1
68	TYPE J MANHOLE 5'-0" DIA.	118.43	PHASE 1
69	MES 42" RCP		PHASE 1
70	MES 36" RCP		PHASE 1
71	MES 36" RCP		PHASE 2
72	MES 36" RCP		PHASE 1
73	FES 30" RCP		PHASE 1
74	MES 24" RCP		PHASE 1
75	MES 36" RCP		PHASE 1
CS-100	TYPE E CONTROL STRUCTURE	116.30	PHASE 2
CS-110	TYPE D CONTROL STRUCTURE	116.50	PHASE 2
CS-120	TYPE D CONTROL STRUCTURE	116.20	PHASE 1
CS-130	TYPE D CONTROL STRUCTURE	114.80	PHASE 1

STRUCTURE TABLE			
STR. NO.	STR. TYPE	TOP ELEV.	COMMENTS
CS-140	TYPE C CONTROL STRUCTURE	116.00	PHASE 1
CS-150	TYPE E CONTROL STRUCTURE	114.33	PHASE 1

PIPE TABLE							
START STR.	END STR.	PIPE DIMENSION & MATERIAL	LENGTH	SLOPE	START INV.	END INV.	FALL IN FEET
68	69	42" RCP	167	0.06%	108.10	108.00	0.10
CS-100	70	36" RCP	37	0.27%	111.00	110.90	0.10
CS-110	71	36" RCP	35	0.28%	111.60	111.50	0.10
CS-120	72	36" RCP	48	0.21%	108.30	108.20	0.10
CS-130	73	30" RCP	50	0.20%	108.00	107.90	0.10
CS-140	74	24" RCP	46	0.22%	109.10	109.00	0.10
CS-150	75	36" RCP	35	0.29%	110.50	110.40	0.10

NOTE:

- ALL INLET AND MANHOLE STRUCTURE BOTTOMS ARE SPECIFIED TYPE 'P' UNLESS OTHERWISE NOTED. REFER TO FDOT DESIGN STANDARD INDEX 425-010.
- ALL FLARED END SECTIONS (FES) ARE SPECIFIED FDOT STANDARD INDEX 430-020 UNLESS OTHERWISE NOTED.
- ALL MITERED END SECTIONS (MES) ARE SPECIFIED FDOT STANDARD INDEX 430-021 UNLESS OTHERWISE NOTED.



HEIDT DESIGN
Civil Engineering • Planning & GIS
Transportation Engineering
Ecological Services • Landscape Architecture

5904-A Hampton Oaks Pkwy
Tampa, Florida 33610
Office: 813-253-5311
Fax: 813-464-7629
www.HeidtDesign.com

SERENOA VILLAGE 3 - PHASE 1, 2 & 3

STORM STRUCTURE DATA

PREPARED FOR: **VK AVALON GROVES, LLC**

02/07/2021	ADDED PH2 RECORD INFORMATION	DATE	DESCRIPTION
05/24/2021	REVISED MULTIPLE PIPE INVERTS	DATE	DESCRIPTION
07/26/2021	REVISED MULTIPLE PIPE INVERTS	DATE	DESCRIPTION
11/23/2021	REV. STRUCTURE NUMBERS	DATE	DESCRIPTION
11/28/2021	REVIEW SUBMITTAL	DATE	DESCRIPTION

PROJECT NO: KLP-AG-1089
 FILE: ST-REC
 DESIGN BY: FRANCIS
 DRAWN BY: JLOAIZA

STATE OF FLORIDA
PROFESSIONAL ENGINEER

Timothy M. Plate, P.E. (State of Florida, Professional Engineer, License No. 41153)
 This item has been digitally signed and sealed by Timothy M. Plate, P.E. on the date indicated here:
 Printed copies of this document are not considered signed and sealed and the signature must be verified on any electronic copies.

TIMOTHY M. PLATE, P.E.
 DATE: _____
 LICENSE NO. 41153

C-313

R:\AVALON GROVES\VILLAGE 3\ENGINEERING\RECORD\PHASE 2\ST-REC.DWG-C-313 20220216 10:57 AM ALICIA SHIRES